


STATE OF KANSAS
STATE CORPORATION COMMISSION

WELL PLUGGING RECORD

Give All Information Completely
Make Required Affidavit
Mail or Deliver Report to
Conservation Division
State Corporation Comm.
245 North Water
Wichita, KS 67202

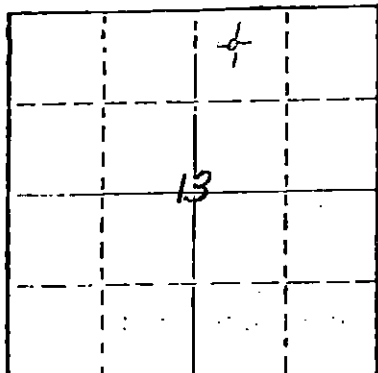

Locate well correctly on above
Section Plat

Hodgeman County, Sec. 13 Twp. 21S Rge. 24W E/W
Location as "NE/CNW 1/4 SW 1/4" or footage from lines
660' from N line 1980' from East line
Lease Owner Galloway Drilling Co., Inc.
Lease Name Rankin Well No. 2
Office Address 105 So. Broadway, Wichita, KS 67202
Character of Well (Completed as Oil, Gas or Dry Hole)
Dry Hole

Date Well completed 10/26/81 19
Application for plugging filed 10/26/81 19
Application for plugging approved 10/26/81 19
Plugging commenced 10/26/81 19
Plugging completed 10/26/81 19
Reason for abandonment of well or producing formation
Dry hole

If a producing well is abandoned, date of last production
n/a 19

Was permission obtained from the Conservation Division or
its agents before plugging was commenced? Yes

Name of Conservation Agent who supervised plugging of this well Wm. T. Owen
Producing formation n/a Depth to top Bottom Total Depth of Well
Show depth and thickness of all water, oil and gas formations.

OIL, GAS OR WATER RECORDS

CASING RECORD

| FORMATION | CONTENT | FROM | TO | SIZE | PUT IN | PULLED OUT |
|-----------|---------|------|----|-------|--------|------------|
| | | | | 8 5/8 | 304' | none |

Describe in detail the manner in which the well was plugged, indicating where the mud fluid
was placed and the method or methods used in introducing it into the hold. If cement or other
plugs were used, state the character of same and depth placed, from feet to
feet for each plug set.

Circ heavy mud 1st plug 900', 70 sacks, 2nd plug 300'
40 sacks, bridge 40' 10 sacks rat hole 5 sacks 40-40 POZ
3% Cal. Cl. 4% Gel plugged 3:30 P.M.

(If additional description is necessary, use BACK of this sheet)

Name of Plugging Contractor Galloway Drilling Co., INC.

STATE OF Kansas COUNTY OF Sedgwick ss.

Jay H. Galloway (employee of owner) or (owner or operator) of the above-described
well, being first duly sworn on oath, says: That I have knowledge of the facts, statements, and matters herein contained and the log of the
above-described well as filed and that the same are true and correct. So help me God.

(Signature)

Jay H. Galloway
340 Broadway Plaza Bldg., Wichita, KS

105 So November 19 81

EARLENE M. LUMRY
STATE NOTARY PUBLIC
SEDGWICK COUNTY, KANSAS
MY APPT. EXP.

My commission expires

September 7, 1985

Earlene M. Lumry

Notary Public

RECEIVED
STATE CORPORATION COMMISSION

NOV 19 1981

CONSERVATION DIVISION
Wichita, Kansas

11-19-81