


Give All Information Completely
Make Required Affidavit
Mail or Deliver Report to:
Conservation Division
State Corporation Commission
212 No. Market
Wichita, Kansas

WELL PLUGGING RECORD

Hodgeman County, Sec. 13 Twp. 21S Rge. (X) 24 (W)

Location as "NE/CNW/SW" or footage from lines C SE SE
Lease Owner Pickrell Drilling Company
Lease Name Goebel East Unit (formerly Hollenbeck) Well No. H-3
Office Address 110 North Market, Suite 205, Wichita, KS 67202
Character of Well (completed as Oil, Gas or Dry Hole) Oil converted to SWD
Date well completed (as oil well) (See note below) 12-20-1963
Application for plugging filed 7-31-1981 **
Application for plugging approved 8-11-1981
Plugging commenced 10-20-1981
Plugging completed 11-28-1981
Reason for abandonment of well or producing formation Mechanical problems prevented reasonable operation of well as SWD.
If a producing well is abandoned, date of last production 7-8-1972
Was permission obtained from the Conservation Division or its agents before plugging was commenced? Yes

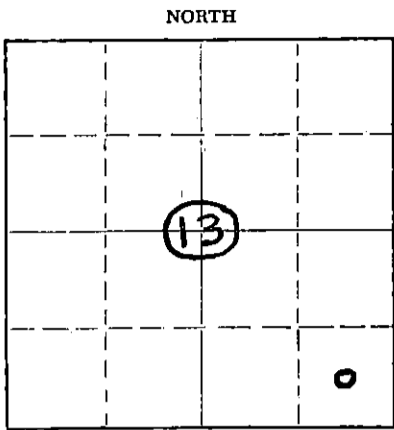

Locate well correctly on above Section Plat

Name of Conservation Agent who supervised plugging of this well Steve Durrant
Producing formation Mississippian Depth to top 4445' Bottom 4503' (TD) Total Depth of Well 4503 Feet
Show depth and thickness of all water, oil and gas formations.

OIL, GAS OR WATER RECORDS

CASING RECORD

FORMATION	CONTENT	FROM	TD	SIZE	PUT IN	PULLED OUT
Mississippian	Oil & Water	4445'	4503'	8 5/8"	276	None
				5 1/2"	4475	None

Describe in detail the manner in which the well was plugged, indicating where the mud fluid was placed and the method or methods used in introducing it into the hole. If cement or other plugs were used, state the character of same and depth placed, from _____ feet to _____ feet for each plug set.

Well was an oil well converted to SWDW in the Mississippian formation 4475'-4503' (open hole). The Mississippian ceased to take fluid satisfactorily and a cast iron bridge plug was set at 1500', preparing to convert the well to a Cedar Hills disposal. At this time a casing leak or leaks was discovered in the 5 1/2" casing and it was decided to permanently plug and abandon the well. On 10-20-81, Allied Cementing pumped 200 sx 50-50 Pozmix cement (6% gel) into the well on a vacuum. After 3 hrs Allied pumped an additional 91 sx cement attempting to fill top 400' which remained empty. On 11-27-81 and again on 11-28-81, one and one-half cubic yards of Ready-Mix cement was pumped into the well and the hole stayed full.

(If additional description is necessary, use BACK of this sheet)
Name of Plugging Contractor Allied Cementing Company
Address Box 31, Russell, Kansas 67665

STATE OF Kansas, COUNTY OF Sedgwick, ss. Jack Gurley (employee of owner) or (owner or operator) of the above-described well, being first duly sworn on oath, says: That I have knowledge of the facts, statements, and matters herein contained and the log of the above-described well as filed and that the same are true and correct. So help me God.

(Signature) Jack Gurley
Jack Gurley, 110 N. Market, Wichita, KS 67202 (Address)

SUE A. BROWNLEE
NOTARY PUBLIC
STATE OF KANSAS
My Appt. Expires November 24, 1985

Sue A. Brownlee Notary Public.

** Note -- Well was converted to SWD 9-1-72 (Order No. G-16699)

NOTARY DRILLING LOG

COMPANY: PICKRELL DRILLING COMPANY
 705 4th National Bank Bldg.
 Wichita, Kansas
 LOCATION: HOLLERBECK No. 3, C SE SE Sec. 13-21-24W,
 Hodgeman County, Kansas.

Rotary Drilling Commenced 11-16-63
 Rotary Drilling Completed 12-09-63

CONTRACTOR: PICKRELL DRILLING COMPANY
 Wichita, Kansas

CASING RECORD: (11 jts) 276' 3 5/8" surface casing set with 160 sacks cement.
 Circulated. (140 jts) 5 1/2" casing set at 4475' with 75 sacks
 cement. Completed 3:30 A.M. December 9, 1963.

LOG

(Figures indicate bottom of formation — measurements from top of rotary bushing.)

20	Sandy Clay	<u>C. F. S.</u>
730	Shale & Shells	4385
925	Red Beds	4453
950	Blaine	4473
1025	Shale, Shells & Red Beds	4476
1160	Sand	4482
1545	Shale & Shells	
1590	Anhydrite	<u>Stone Tart</u>
2145	Shale & Shells	2500
2465	Lime & Shale	3000
2850	Lime	3500
3400	Lime & Shale	4000
3590	Sandy Shale & Lime	
3835	Lime & Shale	<u>S. L. M.</u>
4440	Lime	3678
4476	Lime & Chert	4083
4482	Mississippian - TD	4307

RECEIVED
 STATE CORPORATION COMMISSION
 1 AUG - 3 1963
 CONSERVATION DIVISION
 Wichita, Kansas

The undersigned, C. W. SHELTS, Attorney-in-Fact for PICKRELL DRILLING COMPANY, hereby certifies in behalf of said Company, that the above is a true and correct log of the formation encountered in drilling the above well as reflected by the Daily Drilling Reports.

PICKRELL DRILLING COMPANY

By C. W. SHELTS Attorney-in-Fact

STATE OF KANSAS }
 COUNTY OF SEDGWICK } ss.:

On this 11th day of December, 1963, before me the undersigned, a Notary Public, in and for the County and State aforesaid, personally appeared _____, to me known to be the identical person who subscribed the name of PICKRELL DRILLING COMPANY to the foregoing instrument as its Attorney-in-Fact and acknowledged to me that he executed the same as his free and voluntary act and deed, and as the free and voluntary act and deed of such company, for the uses and purposes therein set forth.

Given under my hand and seal of office the day and year last above written.

My commission expires: June 21, 1966

Maxine Blackman
 Notary Public