


STATE OF KANSAS
STATE CORPORATION COMMISSION

WELL PLUGGING RECORD

Give All Information Completely
Make Required Affidavit
Mail or Deliver Report to
Conservation Division
State Corporation Comm.
245 North Water
Wichita, KS 67202

Hodgeman County. Sec. 20 Twp. 21S Rge. 25W E/W
Location as "NE/CNW 1/4 SW 1/4" or footage from lines C/NE SE

Lease Owner National Crude
Lease Name Chelseth Well No. #1
Office Address Suite 540, 7701 East Kellogg, Wichita, Kansas
Character of Well (Completed as Oil, Gas or Dry Hole) 67207
Dry hole

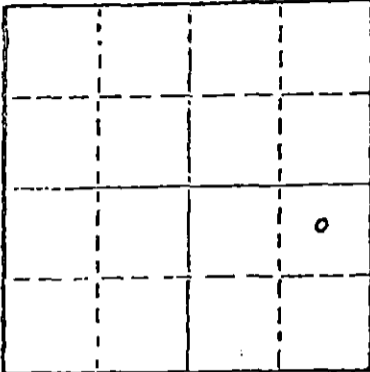

Locate well correctly on above
Section Plot

Date Well completed December 14 19 76
Application for plugging filed December 14 19 76
Application for plugging approved December 14 19 76
Plugging commenced December 14 19 76
Plugging completed December 14 19 76
Reason for abandonment of well or producing formation Dry hole

If a producing well is abandoned, date of last production 19

Was permission obtained from the Conservation Division or its agents before plugging was commenced? yes

Name of Conservation Agent who supervised plugging of this well Clarence Thomas
Producing formation _____ Depth to top _____ Bottom _____ Total Depth of Well _____

Show depth and thickness of all water, oil and gas formations.

OIL, GAS OR WATER RECORDS

CASING RECORD

FORMATION	CONTENT	FROM	TO	SIZE	PUT IN	PULLED OUT
	8-5/8"	0	380			

Describe in detail the manner in which the well was plugged, indicating where the mud fluid was placed and the method or methods used in introducing it into the hold. If cement or other plugs were used, state the character of same and depth placed, from _____ feet to _____ feet for each plug set. Plugged at 900' with 50 sacks of 50-50 pozmix; plugged at 350' with 35 sacks 50-50 pozmix; plugged at 40' with 15 sacks 50-50 pozmix. Plugged rathole and mousehole with 5 sacks each. Plug down at 2:20 P.M. December 14, 1976.

RECEIVED
STATE CORPORATION COMMISSION

MAR 17 1977

3-17-77

CONSERVATION DIVISION
Wichita, Kansas

(If additional description is necessary, use BACK of this sheet)

Name of Plugging Contractor Strata Drilling Company


STATE OF KANSAS COUNTY OF BARTON, ss.
Kenneth J. Link (employee of owner) or (owner or operator)
of the above-described well, being first duly sworn on oath, says: That I have knowledge of the facts, statements, and matters herein contained and the log of the above-described well as filed and that the same are true and correct. So help me God.

(Signature) Kenneth J. Link President
Box 355, Great Bend, Kansas 67530
(Address)

SUBSCRIBED AND SWORN TO before me this 22nd day of December, 1976

Joy Selves
Joy Selves Notary Public.

My commission expires November 30, 1979

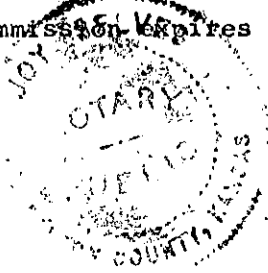

D R I L L E R S L O G

#1 Chelseth

CASING RECORD: 375.95' of used 8-5/8" 28# surface casing.	COMPANY: National Crude	DESCRIPTION: C/NE SE Section 20-21S-25W Hodgeman County, Kansas
TOTAL DEPTH: 4480'	CONTRACTOR: Strata Drilling Company	
	COMMENCED: December 6, 1976	
	COMPLETED: December 14, 1976	
	D. & A.	

<u>FORMATION</u>	<u>FROM</u>	<u>TO</u>	<u>REMARKS</u>
Surface soil	0	390	Ran 375.95' of used 8-5/8" 28# surface casing, set and cemented @ 378' with 270 sacks of common cement, 2% gel and 3% C.C., cement circulated; plug down at 3:15 A.M. December 7, 1976.
Shale	390	500	
Shale, sand, shale	500	1597	
Anhydrite	1597	1638	
Lime and Shale	1638	4465	
Lime	4465	4480	

ROTARY TOTAL DEPTH: 4480'

Ran two Drill Stem Tests.

Ran one electric log.

D. & A.

RECEIVED
 STATE COOPERATION COMMISSION
 MAR 02 1977
 CONSERVATION DIVISION
 Wichita, Kansas

Hole plugged as follows: plugged at 900' with 50 sacks of 50-50 pozmix; plugged at 350' with 35 sacks 50-50 pozmix; plugged at 40' with 15 sacks 50-50 pozmix. Plugged rathole and mousehole with 5 sacks each. Plug down at 2:20 P.M. December 14, 1976.

STATE OF KANSAS)
) ss
 COUNTY OF BARTON)

I certify that this is a true and correct copy of the above log to the best of my knowledge.

STRATA DRILLING COMPANY

Kenneth J. Link
 Kenneth J. Link, President

Subscribed and sworn to before me this 22nd day of December, 1976.

My Commission Expires:

November 30, 1979



Joy Selves
 Joy Selves, Notary Public