


STATE OF KANSAS
STATE CORPORATION COMMISSION

Give All Information Completely
Make Required Affidavit
Mail or Deliver Report to:
Conservation Division
State Corporation Commission
212 No. Market
Wichita, Kansas

WELL PLUGGING RECORD

NORTH

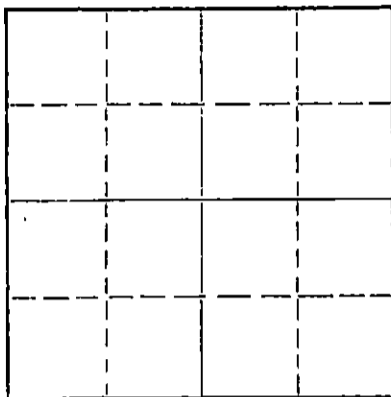

Locate well correctly on above
Section Plat

Hodgeman County. Sec. 26 Twp. 21S Rge. 25 (E) W (W)
Location as "NE/CNW/SW" or footage from lines C/SE SW
Lease Owner Raymond Oil Company
Lease Name Williams Well No. 1
Office Address 410 Fourth National Bank Bldg., Wichita, Ks.
Character of Well (completed as Oil, Gas or Dry Hole) D&A
Date well completed January 31, 1969
Application for plugging filed January 31, 1969
Application for plugging approved January 31, 1969
Plugging commenced January 31, 1969
Plugging completed January 31, 1969
Reason for abandonment of well or producing formation D&A

If a producing well is abandoned, date of last production _____ 19____
Was permission obtained from the Conservation Division or its agents before plugging was commenced? Yes

Name of Conservation Agent who supervised plugging of this well Edgar J. Eves
Producing formation _____ Depth to top _____ Bottom _____ Total Depth of Well 4562' Feet
Show depth and thickness of all water, oil and gas formations.

OIL, GAS OR WATER RECORDS

CASING RECORD

FORMATION	CONTENT	FROM	TO	SIZE	PUT IN	PULLED OUT
				9"	255.55	-0-

Describe in detail the manner in which the well was plugged, indicating where the mud fluid was placed and the method or methods used in introducing it into the hole. If cement or other plugs were used, state the character of same and depth placed, from _____ feet to _____ feet for each plug set.

Plugged hole w/ 80 sx
@ 900' to 600'; 30 sx
@ 265' to 165'; 15 sx
@ 45' to surface - by
HOWCO

2-10-69

RECEIVED
STATE CORPORATION COMMISSION
FEB 10 1969
CONSERVATION DIVISION
Wichita, Kansas

(If additional description is necessary, use BACK of this sheet)

Name of Plugging Contractor Red Tiger Dilling Company
Address 1720 Wichita Plaza, Wichita, Kansas 67202

STATE OF Kansas, COUNTY OF Sedgwick, ss.
Norman E. Klein (employee of owner) or (owner or operator) of the above-described well, being first duly sworn on oath, says: That I have knowledge of the facts, statements, and matters herein contained and the log of the above-described well as filed and that the same are true and correct. So help me God.

(Signature) Norman E. Klein
1720 Wichita Plaza, Wichita, Kansas
(Address)

SUBSCRIBED AND SWORN TO before me this 6th day of February, 1969

Gloria Sawcett
Notary Public.

My commission expires 10-25-72



DRILLERS LOG

No. 1 Williams

CASING RECORD: 9" @ 263' w/175 sx cement
 COMPANY: Raymond Oil Company
 CONTRACTOR: Red Tiger Drilling Co.
 COMMENCED: January 20, 1969
 COMPLETED: January 31, 1969
 DESCRIPTION: C/SE SW 26-21S-25W Hodgeman County, Kansas
 ELEVATION:
 TOTAL DEPTH: 4562'

<u>FORMATION</u>	<u>FROM</u>	<u>TO</u>	<u>REMARKS</u>
Surface Clay & Sand	0	35	
Shale	35	40	
Shale & Sand	40	265	
Shale & Shells w/Sand Stringers	265	800	
Shale, Shells & Red Bed	800	1130	
Sand	1130	1322	
Red Bed & Shale	1322	1560	
Red Bed	1560	1630	
Anhydrite Interlaced w/Shale	1630	1665	
Shale w/Lime Streaks	1665	1930	
Shale & Lime	1930	2735	
Lime	2735	3070	
Lime & Shale	3070	3490	
Shale & Chaiky Lime	3490	3630	
Lime	3630	3745	
Lime w/Shale	3745	3865	
Lime	3865	4400	
Shale w/Lime	4400	4416	
Ft. Scott Lime	4416	4430	
Lime & Shale	4430	4490	
Lime, Shale, some Chert	4490	4530	
Lime w/Shale	4530	4562	

RECEIVED
 STATE CORPORATION COMMISSION
 FEB-10-1969
 CONSERVATION DIVISION
 Wichita, Kansas

I certify that this is a true and correct copy of the above log to the best of my knowledge.

RED TIGER DRILLING COMPANY

Norman E. Klein
 Norman E. Klein

Subscribed and sworn to before me this 10th day of February, 1969.

Gloria Sawcett
 Notary Public

My Commission Expires:

10-25-72