


STATE OF KANSAS
STATE CORPORATION COMMISSION

Give All Information Completely
Make Required Affidavit
Mail or Deliver Report to:
Conservation Division
State Corporation Commission
211 No. Broadway
Wichita, Kansas

WELL PLUGGING RECORD

NORTH

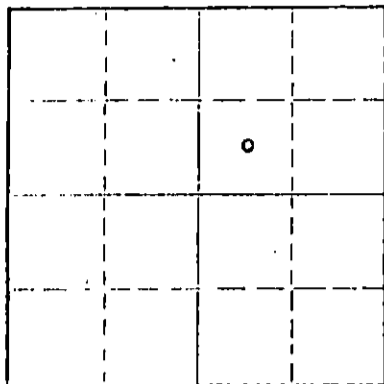

Locate well correctly on above
Section Plot

Kearny County, Sec. 9 Twp. 21S Rge. (E) 36 (W)
Location as "NE/CNWxSWx" or footage from lines 1900' FNL & 1980' FEL
Lease Owner Union Oil Company of California
Lease Name Kuhlman Well No. 1-9
Office Address 619 West Texas Avenue, Midland, Texas
Character of Well (computed as Oil, Gas or Dry Hole) Dry Hole
Date well completed September 13 1964
Application for plugging filed September 21 1964
Application for plugging approved September 1964
Plugging commenced September 15 1964
Plugging completed September 15 1964
Reason for abandonment of well or producing formation Dry

If a producing well is abandoned, date of last production - 19
Was permission obtained from the Conservation Division or its agents before plugging was commenced? Yes

Name of Conservation Agent who supervised plugging of this well Mr. Hugh Scott, Box F, Sublette, Kansas
Producing formation None Depth to top Bottom Total Depth of Well 5160' Feet
Show depth and thickness of all water, oil and gas formations.

OIL, GAS OR WATER RECORDS

CASING RECORD

FORMATION	CONTENT	FROM	TO	SIZE	PUT IN	PULLED OUT
None encountered				8-5/8"	653.45	

Describe in detail the manner in which the well was plugged, indicating where the mud fluid was placed and the method or methods used in introducing it into the hole. If cement or other plugs were used, state the character of same and depth placed, from feet to feet for each plug set.

Mud circulated through drill pipe.

Cement plugs set as follows:

50 sx. 4400-4600'

50 sx. 550-750'

25 sx. 0-60'

Cap Welded on 8-5/8" casing.

9-24-64

RECEIVED
STATE CORPORATION COMMISSION

SEP 24 1964

CONSERVATION DIVISION
Wichita, Kansas

(If additional description is necessary, use BACK of this sheet)
Name of Plugging Contractor Earl F. Wakefield
Address 515 Union Center Building, Wichita, Kansas

STATE OF TEXAS COUNTY OF MIDLAND ss. C. H. Dixon

(employee of owner) or (owner or operator) of the above-described well, being first duly sworn on oath, says: That I have knowledge of the facts, statements, and matters herein contained and the log of the above-described well as filed and that the same are true and correct. So help me God.

(Signature) C. H. Dixon
619 West Texas Avenue, Midland, Texas
(Address)

SUBSCRIBED AND SWORN to before me this 18th day of September, 1964

My commission expires June 1, 1965

Bettie Thomas
~~BEITIE THOMAS~~ Bettie Thomas Notary Public.

15-093-00054.0000

RECEIVED
STATE CORPORATION COMMISSION

SEP 24 1964

9-24-64

CONSERVATION DIVISION
Wichita, Kansas

UNION OIL COMPANY OF CALIFORNIA

NO. 1-9 KUHLMAN

1900' FN & 1980' FE: SECTION 9-21S-36W

WHITE WOMAN CREEK PROSPECT

KEARNEY COUNTY, KANSAS

FORMATION RECORD

Soil, sand and gravel	Surface- 300 feet
Shale, with some limey shale and gray limestone	300- 650 feet
Sandstone and shale.	650-1000 feet
Veri-colored shale, cherty.	1000-1070 feet
Red Beds with reddish and maroon shale minor and anhydrite	1070-1470 feet
Anhydrite and salt, reddish brown and maroon shale	1470-1950 feet
Reddish brown, gritty shale	1950-2190 feet
Anhydrite, gypsum, and brown dolomite	2190-2285 feet
Red and gray shale with anhydrite and salt minor argillaceous dolomite	2285-2700 feet
Sandstone and shale	2700-2770 feet
Gray shale and grey to brown dolomite minor red beds	2770-3025 feet
Limestone, cherty, and gray shale with minor red beds near top	3025-3690 feet
Limestone, cream to buff, cherty with minor dark gray shale	3690-3970 feet
Gray to black shale, coaley	3970-3990 feet
Limestone, gray to buff, oolitic and cherty; minor dark gray to black shale	3990-4500 feet
Shale, dark gray and dark green and gray limestone	4500-4530 feet
Green to gray limestone cherty with minor gray shale	4530-4704 feet
Limestone, cherty, gray to buff, and shale gray to dark green	4704-4940 feet
Shale gray to dark gray and limestone brown to green, dense with minor sandstone	4940-5044 feet'
Light gray limestone, sandy, oolitic	5044-5100 feet TD

GEOLOGIC TOPS

Stone Corral	2190	Heebner	3972
Minnescah	2286	Lensing	3990
Krider	2725	Base Kansas City	4500
Winfield	2772	Marmaton	4528
Lower Fort Riley	2862	Morrow	4888
Shawnee	3690	Mississippian	5050