

WELL PLUGGING RECORD

Give All Information Completely
Make Required Affidavit
Mail or Deliver Report to:
Conservation Division
State Corporation Commission
211 No. Broadway
Wichita, Kansas

Kearny County, Sec. 5 Twp. 21S Rge. (E) 38(W)

Location as "NE/CNWxSWx" or footage from lines. NE SW

Lease Owner Cleary Petroleum, Inc.

Lease Name Rupp Well No. 2

Office Address 310 Kermac Bldg., Oklahoma City, Okla.

Character of Well (completed as Oil, Gas or Dry Hole) Dry Hole

Date well completed August 8, 19 65

Application for plugging filed August 17, 19 65

Application for plugging approved Verbal 8/8 19 65

Plugging commenced 8/8 19 65


Plugging completed 8/9 19 65

Reason for abandonment of well or producing formation

Not productive of oil or gas.

If a producing well is abandoned, date of last production None 19

Was permission obtained from the Conservation Division or its agents before plugging was commenced? Yes

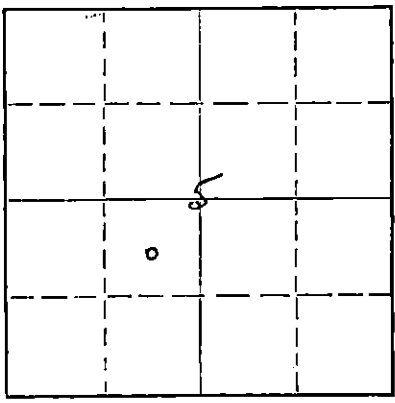

Locate well correctly on above Section Plat

Name of Conservation Agent who supervised plugging of this well W. L. Nichols

Producing formation Not productive Depth to top Bottom Total Depth of Well 5150 Feet

Show depth and thickness of all water, oil and gas formations.

OIL, GAS OR WATER RECORDS

CASING RECORD

FORMATION	CONTENT	FROM	TO	SIZE	PUT IN	PULLED OUT
All formations drilled are thought to be barren of oil, gas, or water.				8 5/8	303	Cement Circulated

Describe in detail the manner in which the well was plugged, indicating where the mud fluid was placed and the method or methods used in introducing it into the hole. If cement or other plugs were used, state the character of same and depth placed, from feet to feet for each plug set.

Hole was drilled with rotary. Mud characteristics as follows: Weight- 9.8#/gal., Viscosity- 45 Sec., Water loss- 8.0 cc.

Cement plugs were spotted through drill pipe as follows:

- 591 to 660 - 69' - 20 sacks
- 228 to 315 - 87' - 25 sacks
- 0 to 40' - 40' - 10 sacks.

Drilling mud filled that portion of the hole not occupied by the cement plugs.

RECEIVED
STATE CORPORATION COMMISSION

8-25-65 AUG 25 1965

CONSERVATION DIVISION
Wichita, Kansas

(If additional description is necessary, use BACK of this sheet)

Name of Plugging Contractor Earl F. Wakefield
Address Union Center Bldg., Wichita, Kan.

STATE OF KANSAS, COUNTY OF SEWARD, ss.
DONALD W. JACKSON (employee of owner) or (owner or operator) of the above-described well, being first duly sworn on oath, says: That I have knowledge of the facts, statements, and matters herein contained and the log of the above-described well as filed and that the same are true and correct. So help me God.

(Signature) Donald W. Jackson
1411 N. Carlton, Liberal, Kansas
(Address)

SUBSCRIBED AND SWORN TO before me this 16th day of August, 19 65

My commission expires
Billye Louise Madden, Notary Public
My Commission Expires February 18, 1968

Billye Louise Madden
Notary Public.

LEASE: RUPP NO. 2
 OWNER: CLEARY PETROLEUM, INC.
 CONT: EARL F. WAKEFIELD
 COMM: 7-20-65
 COMP: 8-6-65

LOCATION: NE SW
 SECTION 5-21S-38W
 KEARNY COUNTY, KANSAS
 CASING: 8 5/8" Set @ 302'

Surface Soil - Clay	150
Sand	241
Yellow Clay	290
Blue Shale	306
Shale & Shells	1206
Red Bed & Shells	1560
Red Bed & Shale	1760
Salt	1830
Red Bed & Shale	1910
Anhydrite	2010
Shale & Anhydrite	2185
Red Bed & Shells	2356
Anhydrite	2371
Shale & Shells	2425
Shale & Shells	2610
Shale & Lime	2754
Lime & Shale	2868
Shale	3020
Lime	3115
Lime & Shale	3210
Lime	3390
Lime, Sand, Shale	3470
Lime	3630
Lime B.	3710
Lime	3853
Lime & Shale	3900
Lime	4030
Lime & Chalk	4123
Lime	5150
R.T.D.	5150

RECEIVED
 STATE CORPORATION COMMISSION
 AUG 25 1965
 CONSERVATION DIVISION
 Wichita, Kansas

STATE OF KANSAS)
) SS
 COUNTY OF SEDGWICK)

I, FRED S. BARKER, DO HEREBY CERTIFY THAT THE ABOVE IS A TRUE AND CORRECT COPY OF THE DRILLER'S LOG ON THE RUPP NO. 2, LOCATED IN THE NE SW OF SECTION 5-21S-38W, KEARNY COUNTY, KANSAS.

EARL F. WAKEFIELD

BY Fred S. Barker

SUBSCRIBED AND SWORN TO BEFORE ME THIS 20TH DAY OF AUGUST, 1965.

MY COMMISSION EXPIRES:
JANUARY 25, 1969

Wanda W. Riley
 WANDA W. RILEY NOTARY PUBLIC