


STATE OF KANSAS
STATE CORPORATION COMMISSION
200 Colorado Derby Bldg.
Wichita, Kansas 67202

nothing
1-21-88

WELL PLUGGING RECORD

Give All Information Completely
Make Required Affidavit

COUNTY Kearny SEC. 1 TWP. 21 RGE. 8 E/W
Location as in quarters or footage from lines:
C-NW

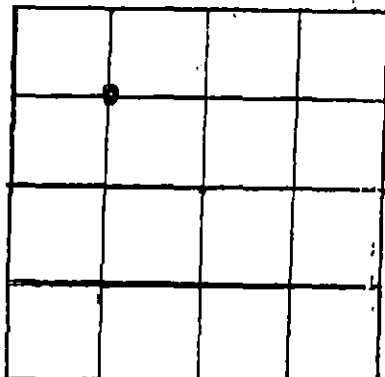

Locate Well
correctly on above
Section Platt.

Lease Owner Osborn Heirs Co.
Lease Name Downs Well No. 2
Office Address P.O. Box 17968, San Antonio, TX 78286
Character of Well (Completed as Oil, Gas or Dry Hole): gas
Date Well Completed 7.23.80
Application for plugging filed 9.14.83
Plugging commenced 11-22-1983
Plugging completed 11-22-1983
Reason for abandonment of well or producing formation

Non commercial value

Was permission obtained from the Conservation Division or it's
Agent's before plugging was commenced? yes

Name of Conservation Agent who supervised plugging of this well Lacy

Producing formation Hugoton Depth to top 2712' bottom 2778' T.D. 2796'

Show depth and thickness of all water, oil and gas formations.

OIL, GAS OR WATER RECORDS

Casing Record

Formation	Content	From	To	Size	Put in	Pulled Out
Surface				8 5/8"	353'	0'
Production				5 1/2"	2796'	0'

Describe in detail the manner in which the well was plugged, indicating where the mud
fluid was placed and the method or methods used in introducing it into the hold. If cement
or other plugs were used, state the character of same and depth placed, from _____ feet
to _____ feet for each plug set.

Pumped 3 sks. hulls - 25 sks. cement - 2 sks. gel - 30 sks. cement
8 sks of gel - 10 sks. cement - 8 sks. gel - 10 sks. cement
2 sks. of gel & 5 sks. cement squeezed to 700 lbs.
Cut off 8 5/8" & 5 1/2", 3' below ground level
Filled 8 5/8" w/ 6 sks. cement

(If additional description is necessary, use BACK of this sheet)

Name of Plugging Contractor Midwest Casing Pulling Service
Lic. # 6497

STATE OF KANSAS COUNTY OF HASKELL, ss.
I, Edgar J. Eves (employee of owner) or (owner or operator) of the
above-described well, being first duly sworn on oath, says: That I have knowledge of the
facts, statements, and matters herein contained and the log of the above-described well as
filed and that the same are true and correct. So help me God.

(Signature) Edgar J. Eves
Box F, Sublette, Ks. 67877
(Address)

SUBSCRIBED AND SWORN TO before me this 30th day of Nov., 19 83

Sondra L Eves
Notary Public.

My Commission expires: 12-6-84

12-8-83

RECEIVED
STATE CORPORATION COMMISSION
DEC 8 1983
CONSERVATION DIVISION
Wichita, Kan.

NOTARY PUBLIC
SONDRA L. EVES
Haskell County, Ks.
My Appt. Exp. 12-6-84