


STATE OF KANSAS  
STATE CORPORATION COMMISSION  
200 Colorado Derby Bldg.  
Wichita, Kansas 67202

WELL PLUGGING RECORD

Give All Information Completely  
Make Required Affidavit

COUNTY Kearny SEC. 1 TWP. 21 RGE. 38 E/W  
Location as in quarters or footage from lines:  
C-SE

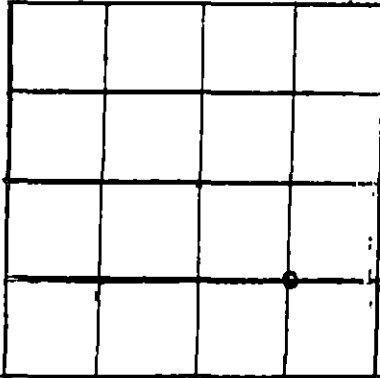

Locate Well  
correctly on above  
Section Platt.

Lease Owner Osborn Heirs Co.  
Lease Name Downs Well No. 1-A  
Office Address P.O. Box 17968, San Antonio, TX 78286  
Character of Well (Completed as Oil, Gas or Dry Hole): gas  
Date Well Completed 10.22.78  
Application for plugging filed 9.14.83  
Plugging commenced 11-22-1983  
Plugging completed 11-22-1983  
Reason for abandonment of well or producing formation Non Commercial Value

Was permission obtained from the Conservation Division or it's  
Agent's before plugging was commenced? yes

Name of Conservation Agent who supervised plugging of this well Mr. Lacy  
Producing formation Hugoton Depth to top 2756' bottom 2698 T.D. 3050'  
Show depth and thickness of all water, oil and gas formations.

OIL, GAS OR WATER RECORDS

Casing Record

| Formation  | Content | From | To | Size   | Put in | Pulled Out |
|------------|---------|------|----|--------|--------|------------|
| Surface    |         |      |    | 8 5/8" | 306'   | 0'         |
| Production |         |      |    | 5 1/2" | 3050'  | 0'         |
|            |         |      |    |        |        |            |

Describe in detail the manner in which the well was plugged, indicating where the mud fluid was placed and the method or methods used in introducing it into the hold. If cement or other plugs were used, state the character of same and depth placed, from \_\_\_\_\_ feet to \_\_\_\_\_ feet for each plug set.

Pumped 3 sks. hulls - 25 sks. cement - 2 sks. gel - 30 sks. cement  
8 sks. of gel - 10 sks. cement - 8 sks. gel - 10 sks. cement  
2 sks. of gel & 5 sks. cement - squeezed to 700 lbs.  
cut off 8 5/8" & 5 1/2", 3' below ground level  
Filled 8 5/8" w/ 10 sks. of cement

(If additional description is necessary, use BACK of this sheet)

Name of Plugging Contractor Midwest Casing Pulling Service  
Lic. # 6497

STATE OF KANSAS COUNTY OF HASKELL, ss.  
I, Edgar J. Eves (~~employee of owner~~) or (owner or operator) of the  
above-described well, being first duly sworn on oath, says: That I have knowledge of the  
facts, statements, and matters herein contained and the log of the above-described well as  
filed and that the same are true and correct. So help me God.

(Signature) Edgar J. Eves  
Box E, Sublette, Ks. 67877  
(Address)

SUBSCRIBED AND SWORN TO before me this 30th day of Nov., 19 83

My Commission expires: 12-6-84

Sandra L Eves  
Notary Public.  
RECEIVED  
STATE CORPORATION COMMISSION  
DEC 8 1983  
CONSERVATION DIVISION  
Wichita, Kansas  
SONDRA L EVES  
Haskell County, Ks.  
My Appt. Exp. 12-6-84

12-8-83