


STATE OF KANSAS  
STATE CORPORATION COMMISSION

Form CP-4

Give All Information Completely  
Make Required Affidavit  
Mail or Deliver Report to:  
Conservation Division  
State Corporation Commission  
212 No. Market  
Wichita, Kansas 67202

WELL PLUGGING RECORD

NORTH

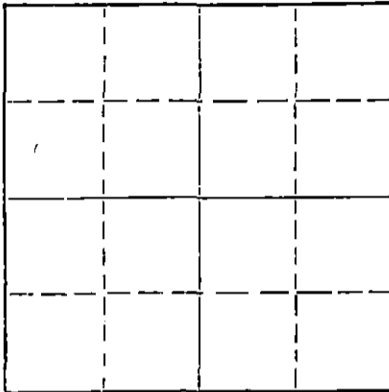

Locate well correctly on above Section Plat

FINNEY County. Sec. 30 Twp. 21S Rge. (E) 33(W)  
Location as "NE/CNW/SW" or footage from lines C NE SE  
Lease Owner MAURICE L. BROWN  
Lease Name LOUIS MAUNE OWWO Well No. 1  
Office Address 1500 Vickers KSB&T Building, Wichita, Kansas 67202  
Character of Well (completed as Oil, Gas or Dry Hole) Dry hole  
Date well completed 11/10 1972  
Application for plugging filed 11/10 1972  
Application for plugging approved 11/10 1972  
Plugging commenced 11/10 1972  
Plugging completed 11/10 1972  
Reason for abandonment of well or producing formation Dry hole

If a producing well is abandoned, date of last production 19  
Was permission obtained from the Conservation Division or its agents before plugging was commenced? yes

Name of Conservation Agent who supervised plugging of this well EDGAR EVES  
Producing formation \_\_\_\_\_ Depth to top \_\_\_\_\_ Bottom \_\_\_\_\_ Total Depth of Well 4802 Feet  
Show depth and thickness of all water, oil and gas formations.

OIL, GAS OR WATER RECORDS

CASING RECORD

FORMATION	CONTENT	FROM	TO	SIZE	PUT IN	PULLED OUT
Cement		0	240	10"	240	0

Describe in detail the manner in which the well was plugged, indicating where the mud fluid was placed and the method or methods used in introducing it into the hole. If cement or other plugs were used, state the character of same and depth placed, from \_\_\_\_\_ feet to \_\_\_\_\_ feet for each plug set.

1st plug - 700' w/35 sks  
2nd plug - 240' w/30 sks  
Plug and sax hulls @ 40' w/10 sx  
completed @ 12:30 PM 11/10/72

RECEIVED  
STATE CORPORATION COMMISSION  
JAN 19 1973  
CONSERVATION DIVISION  
Wichita, Kansas

(If additional description is necessary, use BACK of this sheet)

Name of Plugging Contractor GABBERT-JONES, INC.  
Address 830 Sutton Place, Wichita, Kansas

STATE OF KANSAS, COUNTY OF SEDGWICK, ss.  
GABBERT-JONES, INC. (employee of owner) or (owner/operator) of the above-described well, being first duly sworn on oath, says: That I have knowledge of the facts, statements, and matters herein contained and the log of the above-described well as filed and that the same are true and correct. So help me God.

(Signature) Jack W. Gabbert, Exec. Vice President  
830 Sutton Place, Wichita, Kansas

SUBSCRIBED AND SWORN TO before me this 18 day of January, 1973

My commission expires

Nov. 29, 1975

Marjorie Hall  
Notary Public.

GABBERT-JONES, INC.  
WICHITA, KANSAS  
DRILLERS' WELL LOG

WICHITA NOV 16 1972

LOUIS MAUNE #1 OWWO  
C NE SE, Section 30-21-33  
Finney County, Kansas

RECEIVED  
STATE CORPORATION COMMISSION

Old Information: Operator: Shallow Water Refining  
Spud: 1/26/44 TD - 4750  
D & A 3/3/44

NOV 20 1972

CONSERVATION DIVISION  
Wichita, Kansas


New Information:

Commenced: 10/29/1972  
Completed: 11/10/72

OPERATOR: MAURICE L. BROWN

Depth		Formation	Remarks
From	To		
0	373	Cement	Ran 240' of 10" (shallow wtr)
373	1041	Mud	
1041	1445	Shale	
1445	4752	Mud	
4752	4802	Coring (Miss)	
4802	TD		D & A

I, James S. Sutton, II, certify this is a correct copy of the Drillers' Log for the well drilled in the C NE SE, Section 30-21-33, Finney County, Kansas, to the best of my knowledge and belief.

  
James S. Sutton, II

STATE OF KANSAS )  
  ) SS  
COUNTY OF SEDGWICK )

Before me, the undersigned, a Notary Public within and for said County and State, on this 15th day of November, 1972, personally appeared James S. Sutton, II to me personally known to be the identical person who executed the within and foregoing instrument and acknowledged to me that he executed the same as his free and voluntary act and deed for the uses and purposes therein set forth.

IN WITNESS WHEREOF, I have hereunto set my hand and official seal the day and year last above written.

  
Marjorie Hall, Notary Public

My commission expires  
November 29, 1975