15-055-00110-0000

STATE OF KANSAS
STATE CORPORATION COMMISSION

Give All Information Completely
Make Required Affidavit
Mail or Deliver Report to:
Conservation Division
State Corporation Commission
800 Bitting Building
Wichita, Kansas

WELL PLUGGING RECORD
OR
FORMATION PLUGGING RECORD

Strike out upper line when reporting plugging off formations.

NORTH

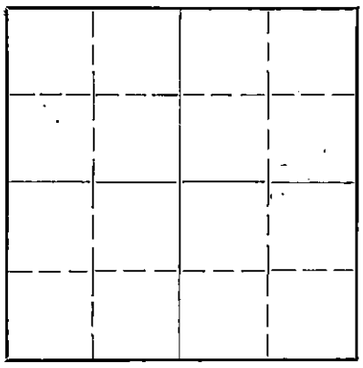

Locate well correctly on above Section Plat

Finney County. Sec. 30 Twp. 21S Rge. 33 (E) - W (W)

Location as "NE¼NW¼SW¼" or footage from lines Center NE¼SE¼

Lease Owner Shallow Water Refining Company

Lease Name First National Bank Well No. 1

Office Address Garden City, Kansas

Character of Well (completed as Oil, Gas or Dry Hole) Dry hole

Date well completed March 3 19 44

Application for plugging filed March 3 19 44

Application for plugging approved March 3 19 44

Plugging commenced March 3 19 44

Plugging completed March 3 19 44

Reason for abandonment of well or producing formation Dry hole

If a producing well is abandoned, date of last production 19

Was permission obtained from the Conservation Division or its agents before plugging was commenced? yes

Name of Conservation Agent who supervised plugging of this well C. T. Alexander

Producing formation Depth to top Bottom Total Depth of Well 4750 Feet

Show depth and thickness of all water, oil and gas formations.

OIL, GAS OR WATER RECORDS — CASING RECORD

Formation	Content	From	To	Size	Put In	Pulled Out
Sand	Water	30	40	10 3/4"	240'	
"	"	60	75			

Describe in detail the manner in which the well was plugged, indicating where the mud fluid was placed and the method or methods used in introducing it into the hold. If cement or other plugs were used, state the character of same and depth placed, from feet to feet for each plug set.

Heavy Mud from 4750' to 240'. Permanent plug placed at 240' and cemented from 240' to 210' with 15 sacks of cement.
Heavy mud from 210' to 26', permanent plug placed at 26' and cemented with 10 sacks of cement from 26' to 6'.

PLUGGING
FILE 30 21S 33W
BOOK PAGE 440 LINE 24

(If additional description is necessary, use BACK of this sheet)

Correspondence regarding this well should be addressed to Shallow Water Refining Company,
Address Garden City, Kansas

STATE OF Kansas, COUNTY OF Sedgwick, ss.

W. A. GRANT, PARTNER (employee of owner) or (owner or operator) of the above-described well, being first duly sworn on oath, says: That I have knowledge of the facts, statements, and matters herein contained and the log of the above-described well as filed and that the same are true and correct. So help me God.

(Signature) [signature]

1019 Central Building, Wichita, Kansas
(Address)

SUBSCRIBED AND SWORN TO before me this 16 day of March 19 44

Ethel Mae Clinton
Notary Public.

My commission expires 10/2/44

19-6929 4-43—6M

3-18-44