

STATE OF KANSAS  
STATE CORPORATION COMMISSION  
CONSERVATION DIVISION  
200 Colorado Derby Building  
Wichita, Kansas 67202

RECEIVED

FORM CP-1  
Rev. 03/92

JUL 13 1998

7-13-98

WELL PLUGGING APPLICATION FORM  
(PLEASE TYPE FORM and File ONE Copy) CONSERVATION DIVISION  
Wichita, Kansas

15-083-10202-0000

API # N/A (Feb. 1964) (Identifier number of this well). This must be listed for wells drilled since 1967; if no API# was issued, indicate spud or completion date.

WELL OPERATOR Pickrell Drilling Company, Inc. KCC LICENSE # 5123  
ADDRESS 110 N. Market, Suite 205 (owner/company name) CITY Wichita, Kansas (operator's)

STATE Kansas ZIP CODE 67202 CONTACT PHONE # (316) 262-8427

LEASE Goebel East Unit "R" WELL# 2 SEC. 13 T. 21S R. 24 (East/West)

- - SE -NW SPOT LOCATION/QQQQ COUNTY Hodgeman

3194' FEET (in exact footage) FROM S/N (circle one) LINE OF SECTION (NOT Lease Line)

3194' FEET (in exact footage) FROM E/W (circle one) LINE OF SECTION (NOT Lease Line)

Check One: OIL WELL  GAS WELL  D&A  SWD/ENHR WELL  DOCKET# \_\_\_\_\_

CONDUCTOR CASING SIZE \_\_\_\_\_ SET AT \_\_\_\_\_ CEMENTED WITH \_\_\_\_\_ SACKS

SURFACE CASING SIZE 8 5/8" SET AT 312 CEMENTED WITH 180 SACKS

PRODUCTION CASING SIZE 5 1/2" SET AT 4472 CEMENTED WITH 75 SACKS

LIST (ALL) PERFORATIONS and BRIDGEPLUG SETS: 4457-4463 (Miss)

ELEVATION 2338' / 2343' T.D. 4473 PSTD 4465 ANHYDRITE DEPTH 1551 (+792)  
(G.L./K.B.) (Stone Corral Formation)

CONDITION OF WELL: GOOD  POOR  CASING LEAK  JUNK IN HOLE

PROPOSED METHOD OF PLUGGING Plug back w/sand to 4400'. Use dump bailer to spot 5sx cement on top of sand. Cut and recover casing. Plug top hole as per instructions of

KCC representative (316) 225-8888.

(If additional space is needed attach separate page)

IS WELL LOG ATTACHED TO THIS APPLICATION AS REQUIRED? Yes IS ACO-1 FILED? Yes

If not explain why? \_\_\_\_\_

PLUGGING OF THIS WELL WILL BE DONE IN ACCORDANCE WITH K.S.A. 55-101 et. seq. AND THE RULES AND REGULATIONS OF THE STATE CORPORATION COMMISSION.

LIST NAME OF COMPANY REPRESENTATIVE AUTHORIZED TO BE IN CHARGE OF PLUGGING OPERATIONS:

Ed Mondero PHONE# (785) 798-2430

ADDRESS P.O. Box 375 City/state Ness City, Kansas 67560

PLUGGING CONTRACTOR Mike's Testing & Salvage, Inc. KCC LICENSE # 31529

ADDRESS P.O. Box 467-Chase, Kansas 67524-0209 (company name) PHONE # (316) 938-2943 (contractor's)

PROPOSED DATE AND HOUR OF PLUGGING (If Known?) 7-15-98

PAYMENT OF THE PLUGGING FEE (K.A.R. 82-3-118) WILL BE GUARANTEED BY OPERATOR OR AGENT

DATE: 7-10-98 AUTHORIZED OPERATOR/AGENT: \_\_\_\_\_

Jack Gurley  
(signature)


New Completion  Workover

Oil Company \_\_\_\_\_ Well No. R-2 Field \_\_\_\_\_ Lease Goebel E. Unit  
Company Man \_\_\_\_\_ Date Drilled 2/64 County Hodgeman State Kansas

RECEIVED  
STATE COOPERATIVE COMMISSION

JUL 13 1964

CONSERVATION DIVISION  
Wichita, Kansas

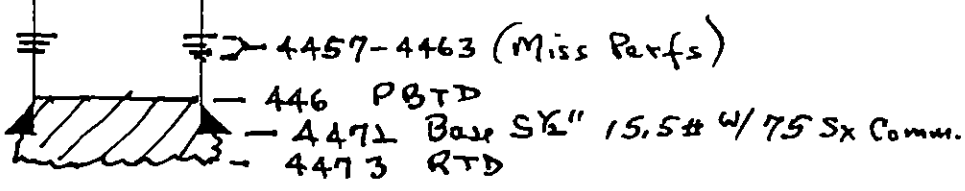

REMARKS: \_\_\_\_\_  
\_\_\_\_\_  
\_\_\_\_\_  
\_\_\_\_\_  
\_\_\_\_\_  
\_\_\_\_\_  
\_\_\_\_\_



## Kansas Corporation Commission

Bill Graves, Governor John Wine, Chair Susan M. Seltsam, Commissioner Cynthia L. Claus, Commissioner

### NOTICE OF RECEIPT OF WELL PLUGGING APPLICATION (CP-1)

July 15, 1998

Pickrell Drilling Company, Inc.  
110 N. Market, Suite 205  
Wichita, Ks. 67202

Goebel East Unit "R" #2  
API 15-08310202 -0000  
SE NW  
Sec. 13-21S-24W  
Hodgeman County

Dear Pickrell Drilling Co.,

This letter is to notify you that the Conservation Division is in receipt of your plugging proposal, form CP-1, for the above-captioned well.

Your CP-1 has been reviewed by the Conservation Division central office for completeness and to verify license numbers. The plugging proposal will now be forwarded to the district office listed below for review of your proposed method of plugging.

**Please contact the district office for approval of your proposed plugging method at least at five (5) days before plugging the well, pursuant to K.A.R. 82-3-113 (b). If a workover pit will be used during the plugging of the well it must be permitted. A CDP-1 form must be filed and approved prior to the use of the pit.**

The Conservation Division's review of form CP-1, either in the central or district office, does not include an inquiry into well ownership or the filing operator's legal right to plug the well.

**This notice in no way constitutes authorization to plug the above-captioned well by persons not having legal rights of ownership or interest in the well. This notice is void after ninety (90) days from the above date.**

Sincerely,

A handwritten signature in cursive script, appearing to read "David P. Williams".

David P. Williams  
Production Supervisor

District: #1  
304 W. McArtor  
Dodge City, KS 67801  
(316) 225-8888