

15.083.10190-0000

STATE OF KANSAS
STATE CORPORATION COMMISSION
CONSERVATION DIVISION
200 Colorado Derby Building
Wichita, Kansas 67202

RECEIVED FORM CP-1
STATE CORPORATION COMMISSION
REVISED 10/92

DEC 07 1994
12-7-94

CONSERVATION DIVISION
WICHITA, KANSAS

WELL PLUGGING APPLICATION FORM
(PLEASE TYPE FORM and File ONE Copy)

API # N/A (Identifier number of this well). This must be listed for wells drilled since 1967; if no API# was issued, indicate spud or completion date.

WELL OPERATOR Pickrell Drilling Co., Inc. KCC LICENSE # 5123
(owner/company name) (operator's)

ADDRESS 110 N. Market, Suite 205 CITY Wichita

STATE Kansas ZIP CODE 67202 CONTACT PHONE # (316) 262-8427

LEASE Goebel East Unit WELL# H-4 SEC. 13 T. 21S R. 24 (East/West)

- C - NE - SE SPOT LOCATION/QQQQ COUNTY Hodgeman

1980 FEET (in exact footage) FROM S/N (circle one) LINE OF SECTION (NOT Lease Line)

810 FEET (in exact footage) FROM E/W (circle one) LINE OF SECTION (NOT Lease Line)

Check One: OIL WELL GAS WELL D&A SWD/ENHR WELL DOCKET# _____

CONDUCTOR CASING SIZE _____ SET AT _____ CEMENTED WITH _____ SACKS

SURFACE CASING SIZE 8 5/8 SET AT 271 CEMENTED WITH 170 SACKS

PRODUCTION CASING SIZE 4 1/2 SET AT 4479 CEMENTED WITH 100 SACKS

LIST (ALL) PERFORATIONS and BRIDGEPLUG SETS: None

ELEVATION 2363 KB T.D. 4496 PBDT Open hole ANHYDRITE DEPTH 1555
(G.L./K.B.) (Stone Corral Formation)

CONDITION OF WELL: GOOD POOR CASING LEAK JUNK IN HOLE

PROPOSED METHOD OF PLUGGING Plug back w/ sand to 4375. Use dump boiler to spot 5 sx. of cement on sand. Cut and recover casing. Plug top hole as directed by K.C.C. representative (316) 225-6760.

(If additional space is needed attach separate page)

IS WELL LOG ATTACHED TO THIS APPLICATION AS REQUIRED? No IS ACO-1 FILED? Yes

If not explain why? Log not available

PLUGGING OF THIS WELL WILL BE DONE IN ACCORDANCE WITH K.S.A. 55-101 et. seq. AND THE RULES AND REGULATIONS OF THE STATE CORPORATION COMMISSION.

LIST NAME OF COMPANY REPRESENTATIVE AUTHORIZED TO BE IN CHARGE OF PLUGGING OPERATIONS:

Ed Mondero PHONE# (913) 798-2430

ADDRESS P.O. Box 375 City/State Ness City, Kansas 67560

PLUGGING CONTRACTOR Mika's Testing & Salvage Inc. KCC LICENSE # 6050
Kelso Casing Pulling, Inc. (contractor's) 31529 9/95

ADDRESS Box 347, Chase, KS 67524-0347 0209 PHONE # (316) 938-2943

PROPOSED DATE AND HOUR OF PLUGGING (If Known?) 12-13-94

PAYMENT OF THE PLUGGING FEE (K.A.R. 82-3-118) WILL BE GUARANTEED BY OPERATOR OR AGENT

DATE: 12-06-94 AUTHORIZED OPERATOR/AGENT: Jack Curley
(Jack Curley)

6/95

1)


New Completion Workover

Oil Company: _____
Company Man _____

Well No. H-4
Date Drilled 9/64

Field Goebel East
County Hodgeman

Lease Goebel E. Unit
State Kansas

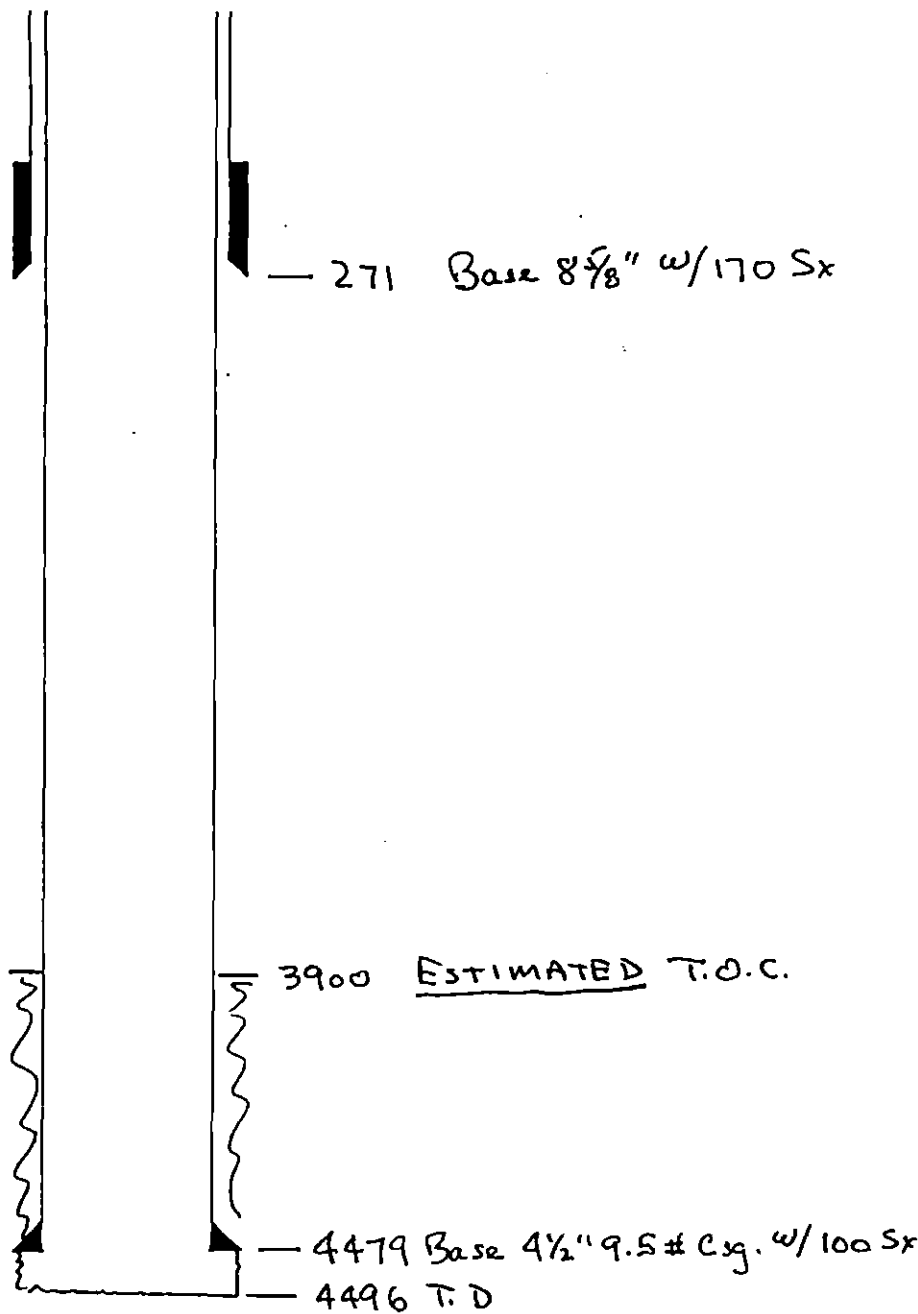

REMARKS: _____

RECEIVED
STATE CORPORATION COMMISSION
DEC 07 1994
CONSERVATION DIVISION
WICHITA, KANSAS



15.083.10190-0000

Kansas Corporation Commission

Joan Finney, Governor Susan M. Seltsam, Chair F.S. Jack Alexander, Commissioner Rachel C. Lipman, Commissioner
Judith McConnell, Executive Director Brian Moline, General Counsel

NOTICE OF RECEIPT OF WELL PLUGGING APPLICATION (CP-1)

December 7, 1994

Pickrell Drilling Co Inc
110 N Market Suite 205
Wichita KS 67202

Goebel East Unit H-4
API 15-N/A
C NE SE
Sec. 13-21S-24W
Hodgeman County

Dear Ed Mondero,

This letter is to notify you that the Conservation Division is in receipt of your plugging proposal, form CP-1, for the above-captioned well.

Your CP-1 has been reviewed by the Conservation Division central office for completeness and to verify license numbers. The plugging proposal will now be forwarded to the district office listed below for review of your proposed method of plugging.

Please contact the district office for approval of your proposed plugging method at least at five (5) days before plugging the well, pursuant to K.A.R. 82-3-113 (b). If a workover pit will be used during the plugging of the well it must be permitted. A CDP-1 form must be filed and approved prior to the use of the pit.

The Conservation Division's review of form CP-1, either in the central or district office, does not include an inquiry into well ownership or the filing operator's legal right to plug the well.

This notice in no way constitutes authorization to plug the above-captioned well by persons not having legal rights of ownership or interest in the well. This notice is void after ninety (90) days from the above date.

Sincerely,

David P. Williams
Production Supervisor

District: #1
304 W. McArtor
Dodge City KS 67801
(316) 225-6760