

AFFIDAVIT AND COMPLETION FORM

ACO-1

This form must be filed in triplicate with the Kansas Corporation Commission, 200 Colorado Derby Building, Wichita, Kansas 67202, within five days after the completion of the well, regardless of how the well was completed. Circle one: Oil, gas, dry, SWD, OWWO, injection. Please type. Complete ALL sections. Applications must be filed for dual completion; commingling, salt water disposal and injection. Attach wireline logs (i.e. electrical log, sonic log, gamma ray neutron log, etc.) KCC#-(316) 263-3238.

OPERATOR Galloway Drilling Co., Inc. API NO. 15-083-20,927-0000  
 ADDRESS 340 Broadway Plaza Bldg. COUNTY Hodgeman  
105 So. Broadway FIELD Goebel  
Wichita, KS 67202

\*\*CONTACT PERSON Earlene Lumry LEASE Rankin  
 PHONE 263-1793 PROD. FORMATION none

PURCHASER none WELL NO. 2  
 ADDRESS \_\_\_\_\_ WELL LOCATION NW/NE


DRILLING CONTRACTOR Galloway Drilling Co., Inc. ~~the~~ SEC. 13 TWP. 21SRGE. 24W  
 ADDRESS same as above

PLUGGING CONTRACTOR Allied Cementing  
 ADDRESS Box 31, Russell, KS 67665

TOTAL DEPTH 4520' PBDT \_\_\_\_\_  
 SPUD DATE 10/17/81 DATE COMPLETED 10/26/81

ELEV: GR2343DF 2345KB 2348

DRILLED WITH (CABLE) (ROTARY) (AIR) TOOLS  
 Report of all strings set — surfaco, intermediate, production, etc. (New) (Used) casing.

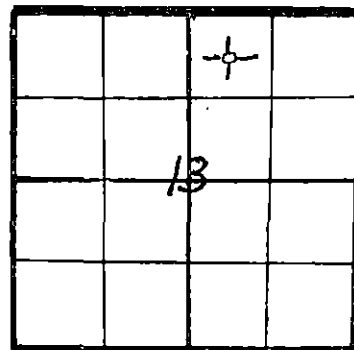

WELL PLAT  
 (Quarter) or (Full) Section -- Please indicate.

KCC   
 KGS   
 MISC.

Purpose of string	Size hole drilled	Size casing set (in O.D.)	Weight lbs/ft.	Setting depth	Type cement	Sacks	Type and percent additives
Surface	12 1/4	8 5/8		304'	Common	200	3% Cal. Ch. + 2% Gel

LINER RECORD			PERFORATION RECORD	
Top, ft.	Bottom, ft.	Sacks cement	Shots per ft.	Size & type
N/A				
TUBING RECORD				
Size	Setting depth	Pecker set at		
N/A				

RECEIVED  
 STATE CORPORATION COMMISSION  
 NOV 10 1981  
 CONSERVATION DIVISION  
 Wichita, Kansas

ACID, FRACTURE, SHOT, CEMENT SQUEEZE RECORD	
Amount and kind of material used	Depth interval treated
N/A	

TEST DATE: N/A		PRODUCTION	
Date of first production	Producing method (flowing, pumping, gas lift, etc.)	A.P.I. Gravity	
N/A			
RATE OF PRODUCTION PER 24 HOURS	Oil	Gas	Water
	bbls.	MCF	%
Disposition of gas (vented, used on lease or sold)		Producing interval(s)	

\*\* The person who can be reached by phone regarding any questions concerning this information.  
 A witnessed initial test by the Commission is required if the well produces more than 25 BOPD or is located in a Basic Order Pool.

Name of lowest fresh water producing stratum Dakota Depth \_\_\_\_\_  
 Estimated height of cement behind pipe no production run

**WELL LOG**

Show all important zones of porosity and contents thereof; cored intervals, and all drill-stem tests, including depth interval tested, cushion used, time tool open, flowing and shut-in pressures, and recoveries.

SHOW GEOLOGICAL MARKERS, LOGS RUN, OR OTHER DESCRIPTIVE INFORMATION.

FORMATION DESCRIPTION, CONTENTS, ETC.	TOP	BOTTOM	NAME	DEPTH
Anhydrite	1580			
Base/ Anhydrite	1595			
Heebner	3800	-1452		
Toronto	3818	-1470		
Lansing	3852	-1504		
Stark	4117	-1769		
Base/KC	4188	-1840		
Marmaton	4213	-1865		
Ft. Scott	4372	-2024		
Cherokee	4398	-2050		
Base/ Cherokee Lime	4444	-2096		
Mississippi	4468	-2120		
Mississippi/Lime	4487	-2139		
Miss./Dol.	4500	-2152		
RTD	4520	-2172		
DST #1 - 4440-72; - 15-45-15-30, 8' mud IBHP 118, FBHP 65, IFD 65, FFP 65.				
DST #2 - 4440-85, 15-45-15-30, 5' mud, IBHP 89, BHP 60, IFP 77, FFP 60.				
D & A				

USE ADDITIONAL SHEETS, IF NECESSARY, TO COMPLETE WELL RECORD.

A F F I D A V I T

STATE OF KANSAS, COUNTY OF SEDGWICK SS,

Jay H. Galloway OF LAWFUL AGE, BEING FIRST DULY SWORN UPON HIS

OATH, DEPOSES AND SAYS:

THAT HE IS President FOR Galloway Drilling Co., Inc.

OPERATOR OF THE Rankin LEASE, AND IS DULY AUTHORIZED TO MAKE THIS AFFIDAVIT FOR AND ON BEHALF OF SAID OPERATOR, THAT WELL NO. 2 ON SAID LEASE HAS BEEN COMPLETED AS OF THE 26 DAY OF October 19 81, AND THAT ALL INFORMATION ENTERED HEREIN WITH RESPECT TO SAID WELL IS TRUE AND CORRECT.

FURTHER AFFIANT SAITH NOT.

(S) [Signature]  
 \_\_\_\_\_  
 9 DAY OF November 19 81

EARLENE M. LUMRY  
 STATE NOTARY PUBLIC  
 SEDGWICK COUNTY, KANSAS  
 MY APPT. EXP. \_\_\_\_\_

[Signature]  
 \_\_\_\_\_  
 NOTARY PUBLIC  
 Earlene M. Lumry

MY COMMISSION EXPIRES: Sept 7, 1985