


STATE OF KANSAS
 STATE CORPORATION COMMISSION
 CONSERVATION DIVISION
 P. O. BOX 17027
 WICHITA, KANSAS 67217

FORM CP-4

WELL PLUGGING RECORD

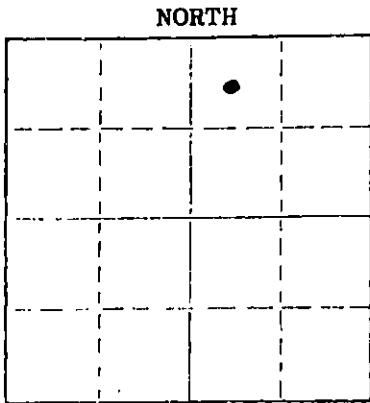

Locate well correctly on above Section Plat

Hodgman County, Sec. 25 Twp. 21 Rge. 23W (E) (W)
 Location as "NE/CNW&SW" or footage from lines C NW NE
 Lease Owner Pickerell Drilling Company
 Lease Name Law B#1 Well No. _____
 Office Address Great Bend, Kansas 67530
 Character of Well (completed as Oil, Gas or Dry Hole) _____
 Date well completed 11-22 1974
 Application for plugging filed 4-2 1975
 Application for plugging approved 4-3 1975
 Plugging commenced 5/20/75 19____
 Plugging completed 5/31/75 19____
 Reason for abandonment of well or producing formation depleted.

If a producing well is abandoned, date of last production 2-28 1975
 Was permission obtained from the Conservation Division or its agents before plugging was commenced? yes

Name of Conservation Agent who supervised plugging of this well Thomas
 Producing formation Mississippi Depth to top 4554 Bottom TD in MS Total Depth of Well 4568
 Show depth and thickness of all water, oil and gas formations.

OIL, GAS OR WATER RECORDS

CASING RECORD

FORMATION	CONTENT	FROM	TO	SIZE	PUT IN	PULLED OUT
Mississippi	Oil & Water	4554	4568	8-5/8	215	none
				5-7/16	2812	2812
					4555	

Describe in detail the manner in which the well was plugged, indicating where the mud fluid was placed and the method or methods used in introducing it into the hole. If cement or other plugs were used, state the character of same and depth placed, from _____ feet to _____ feet for each plug set.

Sanded to 4525' and dumped 5 sacks cement. Shot pipe at 3329', 3206', 3123', 3037', 2837', pulled 70 joints. Pumped 50 sacks cement, displaced 23.46 barrels water to 900', mixed 35 sacks cement, displaced with 12 barrels water to 300', mixed 10 sacks cement to bottom of collar, 40'.

PLUGGING COMPLETE.

Name of Plugging Contractor KELSO CASING PULLING
 Address CHASE, KANSAS

STATE OF KANSAS COUNTY OF RICE, ss.
R. DARRELL KELSO (employee of owner) or (owner or operator) of the above-described well, being first duly sworn on oath, says: That I have knowledge of the facts, statements, and matters herein contained and the log of the above-described well as filed and that the same are true and correct. So help me God.

(Signature) R. Darrell Kelso
CHASE, KANSAS

Subscribed and sworn to before me this 5th day of June, 1975

My commission expires _____



Margaret Melcher
 Notary Public.


RECEIVED
 STATE CORPORATION COMMISSION
 JUN 10 1975
 6-10-75
 CONSERVATION DIVISION
 WICHITA, KANSAS

RECEIVED
STATE CORPORATION COMMISSION
JUN 1975
CONSERVATION DIVISION
Wichita, Kansas

STATE OF KANSAS
STATE CORPORATION COMMISSION
CONSERVATION DIVISION
P. O. BOX 17027
WICHITA, KANSAS 67217

FORM CP-4

WELL PLUGGING RECORD

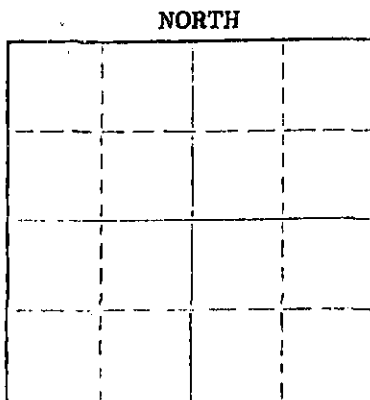

Locate well correctly on above Section Plat

Hodgman County, Sec. 25 Twp. 21 Rge. 23W (E) (W)
Location as "NE/CNW&SW" or footage from lines. C NW NE
Lease Owner: Pickerell Drilling Company
Lease Name: Law B#1 Well No. _____
Office Address: Great Bend, Kansas 67530
Character of Well (completed as Oil, Gas or Dry Hole) _____
Date well completed _____ 19____
Application for plugging filed _____ 19____
Application for plugging approved _____ 19____
Plugging commenced: 5/20/75 _____ 19____
Plugging completed: 5/31/75 _____ 19____
Reason for abandonment of well or producing formation: depleted.
If a producing well is abandoned, date of last production _____ 19____
Was permission obtained from the Conservation Division or its agents before plugging was commenced? yes

Name of Conservation Agent who supervised plugging of this well: Thomas
Producing formation: _____ Depth to top: _____ Bottom: _____ Total Depth of Well: 4568 feet
Show depth and thickness of all water, oil and gas formations.

OIL, GAS OR WATER RECORDS

CASING RECORD

FORMATION	CONTENT	FROM	TO	SIZE	PUT IN	PULLED OUT
				8-5/8	215	none
				5-7/16	2812	2812
					4555	

Describe in detail the manner in which the well was plugged, indicating where the mud fluid was placed and the method or methods used in introducing it into the hole. If cement or other plugs were used, state the character of same and depth placed, from _____ feet to _____ feet for each plug set.

Sanded to 4525' and dumped 5 sacks cement. Shot pipe at 3329', 3206', 3123', 3037', 2837', pulled 70 joints. Pumped 50 sacks cement, displaced 23.46 barrels water to 900', mixed 35 sacks cement, displaced with 12 barrels water to 300', mixed 10 sacks cement to bottom of collar, 40'.

PLUGGING COMPLETE.

(If additional description is necessary, use BACK of this sheet)

Name of Plugging Contractor: KELSO CASING PULLING
Address: CHASE, KANSAS

STATE OF KANSAS COUNTY OF RICE ss. R. DARRELL KELSO

(employee of owner) or (owner or operator) of the above-described well, being first duly sworn on oath, says: That I have knowledge of the facts, statements, and matters herein contained and the log of the above-described well as filed and that the same are true and correct. So help me God.

(Signature) R. Darrell Kelso
CHASE, KANSAS

Subscribed and sworn to before me this 5th day of June, 1975

My commission expires _____
NOTARY PUBLIC
MARGARET MELCHER
Rice County, Ks.
My Comm. Exp. Feb. 15, 1979

Margaret Melcher
Notary Public.

COMPANY: PICKRELL DRILLING COMPANY
705 FOURTH Nat'l BK. Bldg.
Wichita, Ks. 67202

Rotary Drilling Commenced 10-4-74

Rotary Drilling Completed 10-17-74

LOCATION: Law "B" #4
C NW NE Sec. 2521S-23W
Hodgeman County, Kansas.

CONTRACTOR: PICKRELL DRILLING COMPANY
Wichita, Kansas

CASING RECORD: (5 joints) 8 5/8 surface casing set at 215 and cemented with 150 sacks cement. Job completed 10-4-74.
Set 5 1/2" casing at 4555' with 150 sacks cement.

LOG

(Figures indicate bottom of formation — measurements from top of rotary bushing.)

20	Top Soil & Clay
215	Post Rock
985	Shale & Red Bed
1180	Sand
1521	Shale
1535	Anhy
1556	Anhy
1930	Shale
2290	Shale
2455	Shale & Lime
2610	Lime & Shale
2700	Lime & Shale
2810	Lime & Shale
2869	Lime & Shale
3053	Shale & Lime
3193	Shale & Lime
3230	Shale & Lime
3350	Shale & Lime
3460	Lime & Shale
3595	Shale & Lime
3720	Shale & Lime
3910	Shale & Lime
4020	Lime
4170	Lime
4230	Lime & Shale
4300	Lime
4365	Lime & Shale
4420	Lime & Shale
4480	Lime
4505	Lime
4532	Lime & Shale
4534	Shale
4550	Dolomite
4562	Chert. & Dolomite
4568	Miss. Chert.

RECEIVED
STATE CORPORATION COMMISSION
APR 3 1975
CONSERVATION DIVISION
Wichita, Kansas

The undersigned, C. W. Sebitts, Attorney-in-Fact for PICKRELL DRILLING COMPANY, hereby certifies in behalf of said Company, that the above is a true and correct log of the formation encountered in drilling the above well as reflected by the Daily Drilling Reports.

PICKRELL DRILLING COMPANY
By [Signature]
C. W. Sebitts Attorney-in-Fact

STATE OF KANSAS }
COUNTY OF SEDGWICK } ss.:

On this 2 day of January, 19 75, before me the undersigned, a Notary Public, in and for the County and State aforesaid, personally appeared C. W. Sebitts, to me known to be the identical person who subscribed the name of PICKRELL DRILLING COMPANY to the foregoing instrument as its attorney-in-fact and acknowledged to me that he executed the same as his free and voluntary act and deed, and as the free and voluntary act and deed of such company, for the uses and purposes therein set forth.

Given under my hand and seal of office the day and year last above written.

My commission expires: 8-19-75

[Signature]
Notary Public
Helen L. Martin