


STATE OF KANSAS  
STATE CORPORATION COMMISSION

Give All Information Completely  
Make Required Affidavit  
Mail or Deliver Report to:  
Conservation Division  
State Corporation Commission  
212 No. Market  
Wichita, Kansas

WELL PLUGGING RECORD

Hodgeman County, Sec. 25 Twp. 21S Rge. (X) 23 (W)  
Location as "NE/CNW/SE/SW" or footage from lines Qtr. NW NW  
Lease Owner Champlin Petroleum Company  
Lease Name Bamberger Well No. 1  
Office Address P. O. Box 308, Ellinwood, Kansas  
Character of Well (completed as Oil, Gas or Dry Hole) Dry Hole  
Date well completed October 22 19 65  
Application for plugging filed August 28 19 68  
Application for plugging approved September 13 19 68  
Plugging commenced September 25 19 68  
Plugging completed September 25 19 68  
Reason for abandonment of well or producing formation

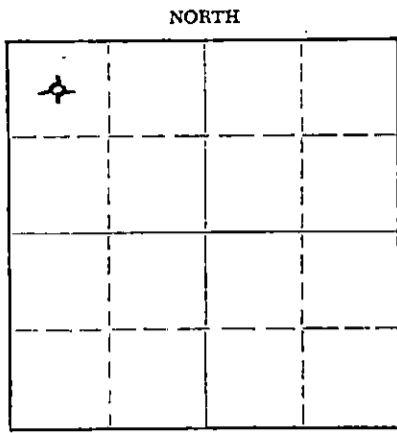

Locate well correctly on above Section Plat

If a producing well is abandoned, date of last production 19  
Was permission obtained from the Conservation Division or its agents before plugging was commenced? Yes

Name of Conservation Agent who supervised plugging of this well Edgar J. Eves, Sublette, Kansas  
Producing formation Depth to top Bottom Total Depth of Well 4570 Feet  
Show depth and thickness of all water, oil and gas formations.

OIL, GAS OR WATER RECORDS

CASING RECORD

FORMATION	CONTENT	FROM	TO	SIZE	PUT IN	PULLED OUT
				8 5/8" OD	275	None
				4 1/2" OD	4569	None

Describe in detail the manner in which the well was plugged, indicating where the mud fluid was placed and the method or methods used in introducing it into the hole. If cement or other plugs were used, state the character of same and depth placed, from feet to feet for each plug set.

Pumped in hulls and water filling hole from 4570' TD to 4554',  
Gel and water to 3814', 10 sacks of cement filling hole to 3669',  
Water from 3669' to 900', 25 sacks of cement filling hole from  
900' to 434', water from 434' to 270', 10 sacks of cement from  
270' to 125', water from 125' to 75', and 5 sacks of cement filling  
hole from 75' to surface.

Used Globe Cementing Company to plug this well.

Mr. Edgar J. Eves was on location and supervised and approved this plugging procedure.

RECEIVED  
STATE CORPORATION COMMISSION  
SEP 30 1968  
CONSERVATION DIVISION  
Wichita, Kansas

9-30-68

(If additional description is necessary, use BACK of this sheet)  
Name of Plugging Contractor Globe Cementing Company  
Address Great Bend, Kansas

STATE OF Kansas, COUNTY OF Barton, ss.  
J. W. Meyers (employee of owner) or (owner) of the above-described well, being first duly sworn on oath, says: That I have knowledge of the facts, statements, and matters herein contained and the log of the above-described well as filed and that the same are true and correct. So help me God.

(Signature) J. W. Meyers, District Operations Manager  
P. O. Box 308, Ellinwood, Kansas  
(Address)

SUBSCRIBED AND SWORN to before me this 27th day of September, 19 68

My commission expires 5/22/70

N. Kenneth Stivers  
Notary Public.

GABBERT-JONES, INC.  
WICHITA, KANSAS  
DRILLERS' WELL LOG

RECEIVED  
STATE CORPORATION COMMISSION  
AUG 29 1968  
CONSERVATION DIVISION  
Wichita, Kansas

BAMBERGER #1  
C NW NW SECTION 25-21S-23W  
HODGEMAN COUNTY, KANSAS

COMMENCED: OCTOBER 2, 1965  
COMPLETED: OCTOBER 13, 1965

OPERATOR - W. A. MONGRIEF

DEPTH		FORMATION	REMARKS
FROM	To		
0	275	SHALE AND POST ROCK	RAN 277' OF 8-5/8" CASING, SET @ 275' w/175 SACKS CEMENT.
275	425	SHALE	
425	525	SAND AND SHALE	
525	815	SHALE AND RED BED	
815	935	SHALE	
935	1165	SAND	
1165	1514	SHALE	
1514	1552	ANHYDRITE	
1552	1560	SHALE	
1560	1880	SHALE AND SHELLS	
1880	2240	SHALE	
2240	3975	SHALE AND LIME	
3975	4280	LIME	
4280	4316	SHALE AND LIME	
4316	4570	LIME	
4570	TD		RAN 139 JOINTS OF 4 1/2" CASING, SET @ 4569' w/750 SACKS CEMENT.

I, E. E. HALL, CERTIFY THIS IS A CORRECT COPY OF THE DRILLERS' LOG FOR THE WELL DRILLED IN THE C NW NW SECTION 25-21S-23W, HODGEMAN COUNTY, KANSAS, TO THE BEST OF MY KNOWLEDGE AND BELIEF.

E. E. HALL

STATE OF KANSAS )  
                          ) SS  
COUNTY OF SEDGWICK )

BEFORE ME, THE UNDERSIGNED, A NOTARY PUBLIC WITHIN AND FOR SAID COUNTY AND STATE, ON THIS 14TH DAY OF OCTOBER, 1965, PERSONALLY APPEARED E. E. HALL, TO ME PERSONALLY KNOWN TO BE THE IDENTICAL PERSON WHO EXECUTED THE WITHIN AND FOREGOING INSTRUMENT AND ACKNOWLEDGED TO ME THAT HE EXECUTED THE SAME AS HIS FREE AND VOLUNTARY ACT AND DEED FOR THE USES AND PURPOSES THEREIN SET FORTH.

IN WITNESS WHEREOF, I HAVE HEREUNTO SET MY HAND AND OFFICIAL SEAL THE DAY AND YEAR LAST ABOVE WRITTEN.

BARBARA J. LAYTON, NOTARY PUBLIC