


WELL PLUGGING RECORD

Give All Information Completely  
Make Required Affidavit  
Mail or Deliver Report to:  
Conservation Division  
State Corporation Commission  
800 Bitting Building  
Wichita, Kansas

Hodgeman County. Sec. 27 Twp. 21 Rge. (E) 23 (W)  
Location as "NE/CNW $\frac{1}{4}$ /SW $\frac{1}{4}$ " or footage from lines NW NE NW $\frac{1}{4}$   
Lease Owner Kingwood Oil Company  
Lease Name Bamberger Well No. 1  
Office Address Craven Bldg., Oklahoma City, Oklahoma  
Character of Well (completed as Oil, Gas or Dry Hole) Dry  
Date well completed October 24 1951  
Application for plugging filed October 24 1951  
Application for plugging approved October 24 1951  
Plugging commenced October 24 1951  
Plugging completed October 24 1951  
Reason for abandonment of well or producing formation Lost hole - Skid rig

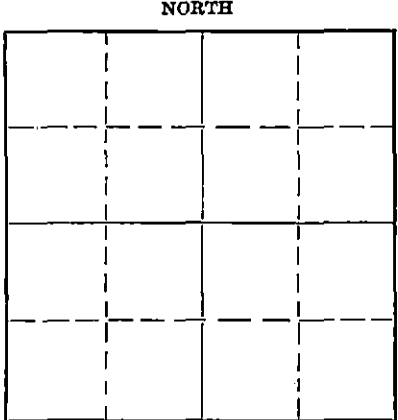

Locate well correctly on above Section Flat

If a producing well is abandoned, date of last production 19  
Was permission obtained from the Conservation Division or its agents before plugging was commenced? Yes

Name of Conservation Agent who supervised plugging of this well C. D. Stough  
Producing formation Depth to top Bottom Total Depth of Well 3015 Feet  
Show depth and thickness of all water, oil and gas formations.

OIL, GAS OR WATER RECORDS

CASING RECORD

Formation	Content	From	To	Size	Put In	Pulled Out
				10-3/4	158	None

Describe in detail the manner in which the well was plugged, indicating where the mud fluid was placed and the method or methods used in introducing it into the hole. If cement or other plugs were used, state the character of same and depth placed, from feet to feet for each plug set.

Filled hole with heavy rotary mud and set plug and 20 sacks cement at 158 ft. Mudded up to 25 ft. and set plug at 25 ft. with 10 sacks cement.

11-10-51

RECEIVED  
STATE CORPORATION COMMISSION

NOV 10 1951

CONSERVATION DIVISION

(If additional description is necessary, use BACK of this sheet)

Correspondence regarding this well should be addressed to M. B. Armer  
Address 710 Petroleum Bldg., Wichita, Kansas

STATE OF Kansas, COUNTY OF Bedgwick  
L. C. Sporenberg (employee of M. B. Armer, Contractor) of the above-described well, being first duly sworn on oath, says: That I have knowledge of the facts, statements, and matters herein contained and the log of the above-described well as filed and that the same are true and correct. So help me God.

(Signature) *L. C. Sporenberg*  
710 Petroleum Bldg., Wichita, Kansas (Address)

SUBSCRIBED AND SWORN to before me this 8 day of November, 19 51

9/17/55

*Hayel Carter*  
Notary Public.

PLUGGING  
FILE SEC 27-T-21-R 230  
BOOK PAGE 19-LINE 37

LOG

Company: Kingwood Oil Company  
 Contractor: M. B. Armer  
 Drilling Commenced: 10-5-51  
 Drilling Completed: 10-25-51  
 Drilled with Unit Rotary

Farm: Carl Bamberger #1  
 Location: NW NE NW 1/4 Sec 27-21-23-W  
 Hodgeman County, Kansas  
 Casing record: 10 3/4 set at 158'  
 cemented w/150 sacks

Elevation: 2341 D.F.; 2338 Gr.

(Figures below indicate bottom)

Surface, clay and shale	158
Shale and Red Bed	588
Blue shale	655
Red Bed	850
Anhy. and Gyp	970
Shale and Red Bed	1025
Sand	1225
Shale and Shells	1565
Anhydrite	1610
Shale and shells	2270
Shale and Lime	2906
Shale	2935
Shale and Lime Streaks	3015
Rotary Total Depth -- last hole	3015 D & A

I hereby certify that this is a true and correct log of the above described well as shown by the drilling reports.

M. B. ARMER

By

*L. C. Sproull*

STATE OF KANSAS )  
 ) SS  
 COUNTY OF SEDGWICK)

STATE COMMISSION  
 NOV 10 1951  
 COMMISSION DIVISION  
 Topeka, Kansas

Subscribed and sworn to before me, a notary public, in and for said County and State this 7th day of November, 1951.

*Hayl Walter*

My commission expires Sept. 17, 1955.

**PLUGGING**  
 FILE SEC-27-T-21-R-230  
 BOOK PAGE 119 LINE 37