


WELL PLUGGING RECORD

Give All Information Completely  
Make Required Affidavit  
Mail or Deliver Report to:  
Conservation Division  
State Corporation Commission  
800 Bittling Building  
Wichita, Kansas

Hodgeman County, Sec. 27 Twp. 21 Rge. (E) 23 (W)  
Location as "NE/CNW $\frac{1}{4}$ SW $\frac{1}{4}$ " or footage from lines NW NE NW $\frac{1}{2}$   
Lease Owner Kingwood Oil Company  
Lease Name C. Bamberger "A" Well No. 1  
Office Address Oklahoma City, Oklahoma  
Character of Well (completed as Oil, Gas or Dry Hole) Dry  
Date well completed Dec. 7 19 51  
Application for plugging filed Dec. 7 19 51  
Application for plugging approved Dec. 7 19 51  
Plugging commenced Dec. 7 19 51  
Plugging completed Dec. 7 19 51  
Reason for abandonment of well or producing formation Dry

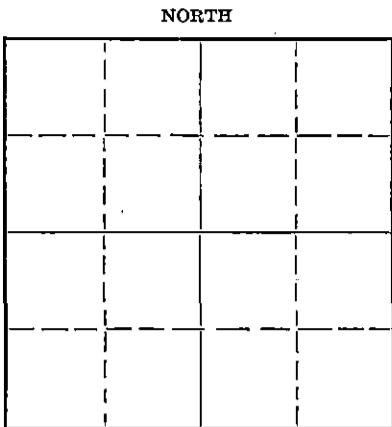

Locate well correctly on above Section Flat

If a producing well is abandoned, date of last production 19...  
Was permission obtained from the Conservation Division or its agents before plugging was commenced? Yes

Name of Conservation Agent who supervised plugging of this well C. D. Stough  
Producing formation Depth to top Bottom Total Depth of Well 5006 Feet  
Show depth and thickness of all water, oil and gas formations.

OIL, GAS OR WATER RECORDS

CASING RECORD

| Formation | Content | From | To | Size   | Put In | Pulled Out |
|-----------|---------|------|----|--------|--------|------------|
|           |         |      |    | 10-3/4 | 160    | None       |
|           |         |      |    |        |        |            |
|           |         |      |    |        |        |            |
Describe in detail the manner in which the well was plugged, indicating where the mud fluid was placed and the method or methods used in introducing it into the hole. If cement or other plugs were used, state the character of same and depth placed, from feet to feet for each plug set.

Filled hole full of heavy mud to 160 ft., set plug and 20 sacks cement at 160 ft. Filled with mud to 35 ft. set plug and 10 sacks cement at the surface

12-20-51

(If additional description is necessary, use BACK of this sheet)

Name of Plugging Contractor M. B. Arner  
Address 710 Petroleum Bldg., Wichita, Kansas

STATE OF Kansas, COUNTY OF Sedgwick, SS.  
I. C. Sponenberg (employee of contractor) of the above-described well,

being first duly sworn on oath, says: That I have knowledge of the facts, statements, and matters herein contained and the log of the above-described well as filed and that the same are true and correct. So help me God.


(Signature) *I. C. Sponenberg*

(Address)

SUBSCRIBED AND SWORN TO before me this 19-th day of December, 19 51.

*Notary Public*  
Notary Public.

My commission expires September 17, 1955

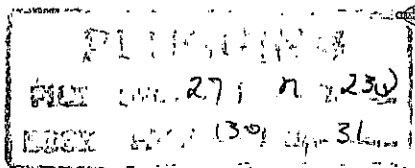

LOG

Company: Kingwood Oil Company  
 Contractor: M/B. Armer  
 Drilling Commenced: 10-26-51  
 Drilling Completed: 12-8-51  
 Elevation: 2341 D.F.  
 2338 Gr.

Farm: Carl Bamberger #1-A  
 Location: 18 ft. South of NW NE NW  
 Sec. 27-218-23W, Hodgeman County, Kans.  
 Casing record: 10-3/4" set at 160 ft.  
 cemented w/125 sacks

(Figures below indicate bottom)

|                               |      |
|-------------------------------|------|
| Surface soil, clay and shells | 55   |
| Clay and shells               | 125  |
| Blue shale                    | 165  |
| 9" to 13-3/4                  | 160  |
| Shale and redbed              | 850  |
| Anhydrate and Gyp             | 1020 |
| Shale                         | 1025 |
| Sand                          | 1225 |
| Shale and shells              | 1555 |
| Anhydrite                     | 1610 |
| Redbed, shale and shells      | 1985 |
| Shale and shells              | 2130 |
| Shale and lime                | 2305 |
| Shale and shells              | 2393 |
| Shale and lime and chert      | 3865 |
| Shale and lime                | 4172 |
| Lime                          | 4222 |
| Lime and shale                | 4241 |
| Lime                          | 4266 |
| Lime and shale                | 4280 |
| Lime and shale                | 4603 |
| Cherty lime                   | 4738 |
| Lime and shale                | 4804 |
| Cherty lime and shale         | 4845 |
| Lime and shale, some chert    | 4865 |
| Lime and shale                | 4948 |
| Shale and cherty lime         | 4965 |
| Lime                          | 4993 |
| Shale and cherty lime         | 5006 |
| Total Depth - - D & A         | 5006 |

I hereby certify that this is a true and correct log of the above described well as shown by the drilling reports.

M. B. ARMER

By *H. P. Spruill*

STATE OF KANSAS )

) SS.

COUNTY OF SEDGWICK)

Subscribed and sworn to before me, a notary public, in and for said Count and State  
18th day of December, 1951.

*Hazel Denton*

My commission expires September 17, 1955

