


STATE OF KANSAS  
STATE CORPORATION COMMISSION

WELL PLUGGING RECORD

Give All Information Completely  
Make Required Affidavit  
Mail or Deliver Report to  
Conservation Division  
State Corporation Comm.,  
245 North Water  
Wichita, KS 67202

Hodgman County, Sec. 27 Twp. 21 Rge. 23 E/W  
Location as "NE/CNW 1/4 SW 1/4" or footage from lines \_\_\_\_\_

NW NW NW  
Lease Owner Thunderbird Drilling, Inc.  
Lease Name Bamberger #1 Well No. \_\_\_\_\_  
Office Address Ellinwood, Kansas 67526  
Character of Well (Completed as Oil, Gas or Dry Hole) \_\_\_\_\_

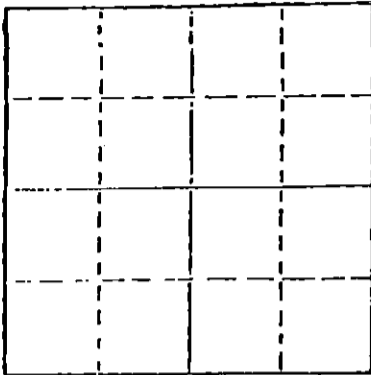

Locate well correctly on above  
Section Plat

Date Well completed \_\_\_\_\_ 19\_\_\_\_  
Application for plugging filed \_\_\_\_\_ 19\_\_\_\_  
Application for plugging approved \_\_\_\_\_ 19\_\_\_\_  
Plugging commenced 3/23/77 \_\_\_\_\_ 19\_\_\_\_  
Plugging completed 3/31/77 \_\_\_\_\_ 19\_\_\_\_  
Reason for abandonment of well or producing formation  
depleted.  
If a producing well is abandoned, date of last production  
\_\_\_\_\_ 19\_\_\_\_

Was permission obtained from the Conservation Division or  
its agents before plugging was commenced? yes

Name of Conservation Agent who supervised plugging of this well Thomas  
Producing formation \_\_\_\_\_ Depth to top \_\_\_\_\_ Bottom \_\_\_\_\_ Total Depth of Well 4575  
Show depth and thickness of all water, oil and gas formations.

OIL, GAS OR WATER RECORDS

CASING RECORD

| FORMATION | CONTENT | FROM | TO | SIZE   | PUT IN | PULLED OUT |
|-----------|---------|------|----|--------|--------|------------|
|           |         |      |    | 8-5/8  | 303    | none       |
|           |         |      |    | 4 1/2" | 4566   | 2625'      |
|           |         |      |    |        |        |            |
|           |         |      |    |        |        |            |

Describe in detail the manner in which the well was plugged, indicating where the mud fluid  
was placed and the method or methods used in introducing it into the hold. If cement or other  
plugs were used, state the character of same and depth placed, from \_\_\_\_\_ feet to  
\_\_\_\_\_ feet for each plug set.

Pumped 30 sacks cement on bottom. Shot pipe at 3502', 3012', 2918',  
2820', 2723', 2620', 2526', pulled 77 joints. Allied pumped 2 sacks  
hulls, 50 sacks cement, 10 sacks gel and 25 sacks cement, 20 sacks gel,  
plug and 15 sacks cement.

PLUGGING COMPLETE.

(If additional description is necessary, use BACK of this sheet)

Name of Plugging Contractor KELSO CASIN G PULLING  
CHASE, KANSAS

STATE OF KANSAS COUNTY OF RICE, ss. 4-5-77  
R. DARRELL KELSO (employee of owner) or (owner or operator)  
of the above-described well, being first duly sworn on oath, says: That I have knowledge of  
the facts, statements, and matters herein contained and the log of the above-described well  
as filed and that the same are true and correct. So help me God.

(Signature) R. Darrell Kelso  
CHASE, KANSAS  
(Address)

SUBSCRIBED AND SWORN TO before me this 31st day of March, 19 77

Margaret Melcher  
Notary Public.

My commission expires \_\_\_\_\_

