


STATE OF KANSAS  
STATE CORPORATION COMMISSION

WELL PLUGGING RECORD

Give All Information Completely  
Make Required Affidavit  
Mail or Deliver Report to  
Conservation Division  
State Corporation Comm.  
245 North Water  
Wichita, KS 67202

Hodgeman County, Sec. 31 Twp. 21S Rge. 23 E/W  
Location as "NE/CNW $\frac{1}{4}$ SW $\frac{1}{4}$ " or footage from lines \_\_\_\_\_  
C NE NW  
Lease Owner Honey Bear Petroleum, Inc.  
Lease Name McGaughy Well No. 1  
Office Address 1441 N. Rock Road, #905, Wichita, Ks 67206  
Character of Well (Completed as Oil, Gas or Dry Hole) \_\_\_\_\_  
dry hole  
Date Well completed \_\_\_\_\_ 1-26 19 81  
Application for plugging filed \_\_\_\_\_ 1-26 19 81  
Application for plugging approved \_\_\_\_\_ 1-26 19 81  
Plugging commenced \_\_\_\_\_ 1-26 19 81  
Plugging completed \_\_\_\_\_ 1-26 19 81  
Reason for abandonment of well or producing formation \_\_\_\_\_  
no commercial quantities of oil or gas encountered  
If a producing well is abandoned, date of last production \_\_\_\_\_  
-- 19

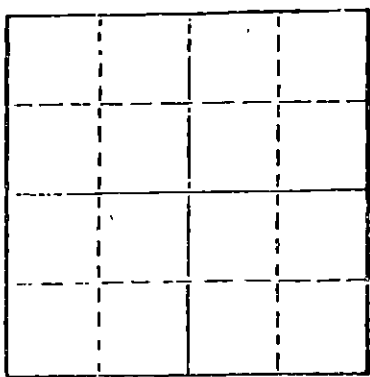

Locate well correctly on above  
Section Plot

Was permission obtained from the Conservation Division or  
its agents before plugging was commenced? yes

Name of Conservation Agent who supervised plugging of this well Clarence Thomas  
Producing formation \_\_\_\_\_ Depth to top \_\_\_\_\_ Bottom \_\_\_\_\_ Total Depth of Well 4660  
Show depth and thickness of all water, oil and gas formations.

OIL, GAS OR WATER RECORDS

CASING RECORD

FORMATION	CONTENT	FROM	TO	SIZE	PUT IN	PULLED OUT
surface hole	shale	surf	366	8-5/8	358	none

Describe in detail the manner in which the well was plugged, indicating where the mud fluid  
was placed and the method or methods used in introducing it into the hold. If cement or other  
plugs were used, state the character of same and depth placed, from \_\_\_\_\_ feet to  
\_\_\_\_\_ feet for each plug set.

Fluid to 900', plug, 60 sx  
Fluid to 380', plug, 35 sx  
Fluid to 40', plug, 10 sx  
Rat hole 5 sx

(If additional description is necessary, use BACK of this sheet)

Name of Plugging Contractor D N B Drilling Inc.  
515 R. H. Garvey Building  
Wichita, Kansas 67202

STATE OF Kansas COUNTY OF Sedgwick, ss.  
James L. Donelson (employee of owner) or (owner or operator)  
of the above-described well, being first duly sworn on oath, says: That I have knowledge of  
the facts, statements, and matters herein contained and the log of the above-described well  
as filed and that the same are true and correct. So help me God.

(Signature) James L. Donelson  
515 R.H. Garvey Bldg., Wichita, Ks. 67202  
(Address)

SUBSCRIBED AND SWORN TO before me this 26th day of January, 19 81

Dorothy L. Schmidt  
Dorothy L. Schmidt Notary Public.  
STATE CORPORATION COMMISSION

My commission expires April 30, 1983

FEB 17 1981  
DOROTHY L. SCHMIDT  
STATE NOTARY PUBLIC  
Sedgwick County, Kansas  
My Appt. Exp. April 30, 1983 Kansas

2-17-81

DRILLER'S LOG

HONEY BEAR PETROLEUM, INC.  
 No. 1 McGaughey  
 C NE NW Sec. 31-21S-23W  
 Hodgeman Co., Ks.

Commenced: 1-19-81  
 Completed: 1-26-81

Surface Casing: 358' of 8-5/8"  
 cmtd w/225 sx common, 2% gel, 3% cc

<u>FORMATION</u>	<u>DEPTH</u>
Surface Hole	0 - 366
Shale	366 - 530
Shale & Sand	530 - 1089
Shale, Sand & Red Bed	1089 - 1500
Shale	1500 - 1632
Anhydrite	1632 - 1678
Shale	1678 - 1910
Shale, Sand & Lime	1910 - 2440
Lime & Shale	2440 - 2925
Shale & Lime	2925 - 3215
Lime & Shale	3215 - 4065
Lime	4065 - 4660 RTD

I do hereby certify that the foregoing statements are true and correct to the best of my knowledge and belief.

D N B DRILLING, INC.

*James L. Donelson*  
 James L. Donelson

STATE OF KANSAS: ss

Subscribed and sworn to before me this 28th day of January, 1981.

*Dorothy L. Schmidt*  
 Dorothy L. Schmidt, Notary Public

RECEIVED  
 FEB 17 1981

CONSERVATION DIVISION  
 Wichita, Kansas

DOROTHY L. SCHMIDT  
 STATE NOTARY PUBLIC  
 Sedgwick County, Kansas  
 My Appt. Exp. April 30, 1983