


15.083.21026-0000

WELL PLUGGING RECORD

Give All Information Completely
 Make Required Affidavit

COUNTY Hodgeman SEC. 31 TWP. 21s RGE. 23wxxxw
 Location as in quarters or footage from lines:
SE NW NE

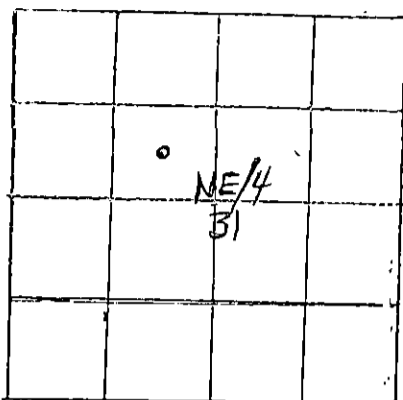

Locate Well
 correctly on above
 Section Platt.

Lease Owner Petromark Exploration, Inc.
 Lease Name Madonna Well No. 31-1
 Office Address P.O. Box 1609, Great Bend, Kansas 67530
 Character of Well (Completed as Oil, Gas or Dry Hole): Dry Hole
 Date Well Completed 3-11-83
 Application for plugging filed 3-11-83
 Plugging commenced 3-11-83
 Plugging completed 3-11-83 1:30 p.m.
 Reason for abandonment of well or producing formation
Dry & abandoned

Was permission obtained from the Conservation Division or it's
 Agent's before plugging was commenced? yes

Name of Conservation Agent who supervised plugging of this well Steve Durrant

Producing formation _____ Depth to top _____ bottom T.D. 4635'

Show depth and thickness of all water, oil and gas formations.

OIL, GAS OR WATER RECORDS

Casing Record

Formation	Content	From	To	Size	Put in	Pulled Out.
				8 5/8"	374'	none

Describe in detail the manner in which the well was plugged, indicating where the mud fluid was placed and the method or methods used in introducing it into the hold. If cement or other plugs were used, state the character of same and depth placed, from _____ feet to _____ feet for each plug set.

1620' 35 sx
390' 50 sx
40' 10 sx
rathole 10 sx

105 sx 50/50 poz, 4% gel, 3% cc

(If additional description is necessary, use BACK of this sheet)


Name of Plugging Contractor Mustang Drilling & Exploration, Inc.

STATE OF Kansas COUNTY OF Barton, ss.

Gib Overbey (employee of owner) or (owner or operator) of the above-described well, being first duly sworn on oath, says: That I have knowledge of the facts, statements, and matters herein contained and the log of the above-described well as filed and that the same are true and correct. So help me God.

(Signature) Gib Overbey
P.O. Box 1609, Great Bend, Kansas
 (Address)

SUBSCRIBED AND SWORN TO before me this _____ 28th day of March, 19 83

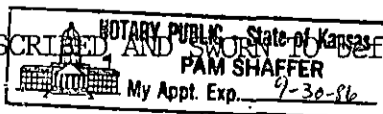

Pam Shaffer
 RECEIVED Notary Public.
 STATE CORPORATION COMMISSION

My Commission expires: 9-30-86

APR 01 1983 41-83