


STATE OF KANSAS
STATE CORPORATION COMMISSION

15-185-21402-0055

WELL PLUGGING RECORD

Give All Information Completely
Make Required Affidavit
Mail or Deliver Report to
Conservation Division
State Corporation Comm.
245 North Water
Wichita, KS 67202

Stafford County, Sec. 7 Twp. 23S Rge. 14 E/W
Location as "NE/CNW 1/4 SW 1/4" or footage from lines
C N/2 SE/4
Lease Owner Allen Drilling Company
Lease Name TANNER Well No. 1
Office Address P.O. Box 1389
Character of Well (Completed as Oil, Gas or Dry Hole)
Dry Hole

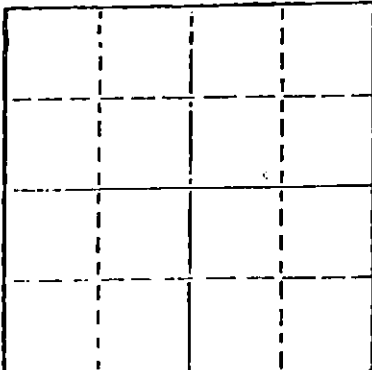

Locate well correctly on above
Section Plat

Date Well completed 9/17 19 81
Application for plugging filed 9/17 1981
Application for plugging approved 9/17 1981
Plugging commenced 9/17 1981
Plugging completed 9/17 1981
Reason for abandonment of well or producing formation
Dry hole

If a producing well is abandoned, date of last production 19

Was permission obtained from the Conservation Division or its agents before plugging was commenced? yes

Name of Conservation Agent who supervised plugging of this well

Producing formation Depth to top Bottom Total Depth of Well 4086'

Show depth and thickness of all water, oil and gas formations.

OIL, GAS OR WATER RECORDS

CASING RECORD

| FORMATION | CONTENT | FROM | TO | SIZE | PUT IN | PULLED OUT |
|-----------|---------|------|------|--------|--------|------------|
| | | 0 | 300' | 8-5/8" | 300' | none |
| | | | | | | |
| | | | | | | |
| | | | | | | |

Describe in detail the manner in which the well was plugged, indicating where the mud fluid was placed and the method or methods used in introducing it into the hold. If cement or other plugs were used, state the character of same and depth placed, from _____ feet to _____ feet for each plug set.

120 sks 50/50 poz, 2% gel, 3% cc: 10-5-81
60 sks @ 660'
40 sks @ 300'
10 sks @ 40'
10 sks rathole
plug down 5:15 PM, 9/17/81

RECEIVED
STATE CORPORATION COMMISSION

OCT 5 1981

CONSERVATION DIVISION
Wichita, Kansas

(If additional description is necessary, use BACK of this sheet)

Name of Plugging Contractor Allen Drilling Company

STATE OF KANSAS COUNTY OF BARTON, ss.
Greg Davidson (employee of owner) or (owner or operator)
of the above-described well, being first duly sworn on oath, says: That I have knowledge of the facts, statements, and matters herein contained and the log of the above-described well as filed and that the same are true and correct. So help me God.

(Signature) Greg Davidson
P.O. Box 1389, Great Bend, KS
(Address)

SUBSCRIBED AND SWORN TO before me this 25th day of September, 19 81



Ruth Brack
Notary Public.

My commission expires _____

15-189-7140Z-5000

RECEIVED
STATE CORPORATION COMMISSION

OCT 5 1981

DRILLER'S WELL LOG

CONSERVATION DIVISION
Wichita, Kansas

DATE COMMENCED: 9/10/81
DATE COMPLETED: 9/17/81

Allen Drilling Company
TANNER No. 1
C N/2 SE/4
Sec. 7, Twp. 23S, Rge. 14W,
Stafford County, Kansas

ELEVATION: 1971' G.L.
1976' K.B.

FORMATION DATA:

| | | | |
|--------------|-------------|-----------|-------|
| 909 - 941' | Anhydrite | Anhydrite | 909' |
| 3433 - 3456' | Shale | Heebner | 3433' |
| 3456 - 3474' | Lime | Toronto | 3456' |
| 3474 - 3570' | Shale | Douglas | 3474' |
| 3570 - 3583' | Lime, shale | B. Lime | 3570' |
| 3583 - 3813' | Lime | Lansing | 3583' |
| 3813 - 4015' | Lime, shale | Base KC | 3813' |
| 4015 - 4039' | Chert | Viola | 4015' |
| 4039 - 4086' | Sand | Simpson | 4039' |
| | RTD | RTD | 4086' |

SURFACE DATA:

Ran 7 jts. new 20# 8-5/8" casing; Tally: 293'
Set @ 300' w/ 285 sks 50/50 poz., 2% gel, 3% cc., cemt. circulated, plug down 7:30 PM, 9/10/81 By Howco

PLUGGING DATA:

120 sks 50/50 poz., 2% gel
3% cc:
60 sks @ 660'
40 sks @ 300'
10 sks @ 40'
10 sks rathole
Plug down 5:15 PM, 9/17/81
By Howco, Bud Metz, plugger

A F F I D A V I T

STATE OF KANSAS)
COUNTY OF BARTON) ss.

Greg Davidson, of lawful age, does swear and state that the facts and statements herein contained are true and correct to the best of his knowledge.

Greg Davidson

Subscribed and Sworn to before me this 25th day of September, 1981.



Ruth Brack
Notary Public