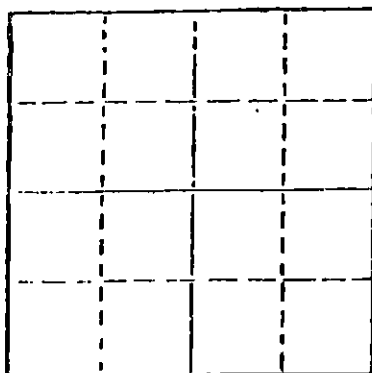


STATE OF KANSAS
STATE CORPORATION COMMISSION

15-185-21132-0000

WELL PLUGGING RECORD

Give All Information Completely
Make Required Affidavit
Mail or Deliver Report to
Conservation Division
State Corporation Comm.
245 North Water
Wichita, KS 67202

Locate well correctly on above
Section Plot

Stafford County, Sec. 8 Twp. 23S Rge. 14W E/W
Location as "NE/CNW $\frac{1}{4}$ SW $\frac{1}{4}$ " or footage from lines
C N/2 N/2 SW/4, Section 8-23S-14W
Lease Owner Black Petroleum Co.
Lease Name SNYDER Well No. #1
Office Address 545 O.W. Garvey Bldg., Wichita, Kansas 67202
Character of Well (Completed as Oil, Gas or Dry Hole)
Dry Hole

Date Well completed 10-17 19 80
Application for plugging filed (Verbally) 10-17 19 80
Application for plugging approved (Verbally) 10-17 19 80
Plugging commenced 10-17 19 80
Plugging completed 10-17 19 80
Reason for abandonment of well or producing formation
No commercial quantity of oil or gas encountered
If a producing well is abandoned, date of last production 19

Was permission obtained from the Conservation Division or
its agents before plugging was commenced? Yes

Name of Conservation Agent who supervised plugging of this well
Producing formation Depth to top Bottom Total Depth of Well
Show depth and thickness of all water, oil and gas formations.

OIL, GAS OR WATER RECORDS

CASING RECORD

FORMATION	CONTENT	FROM	TO	SIZE	PUT IN	PULLED OUT

Describe in detail the manner in which the well was plugged, indicating where the mud fluid was placed and the method or methods used in introducing it into the hold. If cement or other plugs were used, state the character of same and depth placed, from feet to feet for each plug set.

T.D. 4080', Filled hole with mud, pumped 50 sx. of 50/50 posmix, 4% gel thru open end of Drill Pipe @ 480', mud to 40', $\frac{1}{2}$ sx. hulls & wood plug for solid bridge, pumped 10 sx. to base of cellar, 10 sx. in rathole. Completed @ 4:30 p.m. 10-17-80. Cement by Allied.

RECEIVED
STATE CORPORATION COMMISSION

OCT 21 1980 10-21-80

(If additional description is necessary, use BACK of this sheet)

Name of Plugging Contractor KAW Drilling Co., Inc.

CONSERVATION DIVISION
Wichita, Kansas

STATE OF Kansas COUNTY OF Sedgwick, ss.
K.S. Martin, President (employee of owner) or (owner or operator)
of the above-described well, being first duly sworn on oath, says: That I have knowledge of the facts, statements, and matters herein contained and the log of the above-described well as filed and that the same are true and correct. So help me God.


(Signature)

1010 Union Center, Wichita, Kansas 67202

(Address)

SUBSCRIBED AND SWORN TO before me this 20th day of October, 19 80

My commission expires

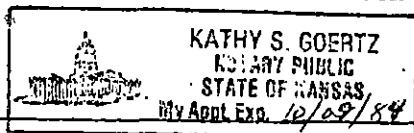

Kathy S. Goertz

Notary Public.

OPERATOR: Black Petroleum Company
CONTRACTOR: KAW Drilling Co., Inc.
WELL NAME: SNYDER #1
LOCATION: C N/2 N/2 SW/4, Section 8-23S-14W
Stafford County, Kansas
SPUD DATE: October 11, 1980
COMPLETION DATE: October 17, 1980

0	230	Shale, shells & sand
230	475	Sand & shale
475	689	Red beds & shale & sand
689	893	Shale
893	922	Anhydrite
922	2000	Shale
2000	2455	Shale & Lime
2455	2778	Shale
2778	3815	Lime & shale
3815	3925	Lime
3925	4080	Lime & shale
	4080'	R.T.D.

SAMPLE TOPS:


Anhydrite 893' (+1078)
B/Anhydrite 922' (+1049)

Spud hole @ 1:00 p.m. 10/11/80. Drilled 475' of 12 $\frac{1}{4}$ " hole. Ran 11 jts. of 8 5/8" - 20#, 8 rd, range 3 new casing. (Tallied 456.72') Set @ 470' K.B. with 350 sx. of 60/40 posmix, 2% gel, 3% Ca.Cl. Cement did circulate. Plug was down @ 8:00 p.m. 10/11/80. Cement by Allied.


T.D. 4080', Filled hole with mud, pumped 50 sx. of 50/50 posmix, 4% gel thru open end of drill pipe @ 480', mud to 40', $\frac{1}{2}$ sx. hulls & wood plug for solid bridge, pumped 10 sx. to base of cellar, 10 sx. in rathole. Completed @ 4:30 p.m. 10-17-80. Cement by Allied.

STATE OF KANSAS)
) SS
COUNTY OF SEDGWICK)

K.S. Martin, President of Kaw Drilling Co., Inc., being first duly sworn on oath, says: That I have knowledge of the facts, statements, and matters herein contained and the log of the above-described well as filed and that the same are true and correct. So help me God.

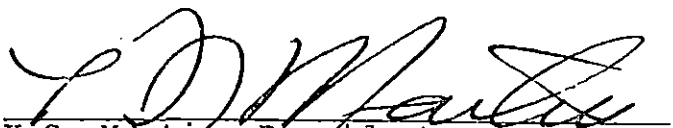
K.S. Martin, President

SUBSCRIBED AND SWORN to before me this 20th day of October, 1980.

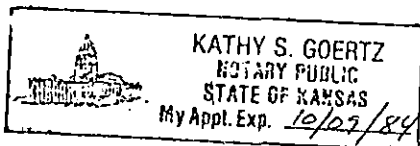


Kathy S. Goertz, Notary Public

RECEIVED
STATE CORPORATION COMMISSION

OCT 21 1980

CONSERVATION DIVISION
Wichita, Kansas