

15-185-2160-0000


STATE OF KANSAS  
STATE CORPORATION COMMISSION

WELL PLUGGING RECORD

Give All Information Completely  
Make Required Affidavit  
Mail or Deliver Report to  
Conservation Division  
State Corporation Comm.  
245 North Water  
Wichita, KS 67202

Stafford County, Sec. 9 Twp. 23S Rge. 14W E/W  
Location as "NE/CNW $\frac{1}{4}$ SW $\frac{1}{4}$ " or footage from lines  
NE SW SE

Lease Owner Oil Properties Co., Inc.  
Lease Name R. J. Welsch Well No. 1  
Office Address Box 335, Andover, Kansas 67002  
Character of Well (Completed as Oil, Gas or Dry Hole)  
Dry Hole

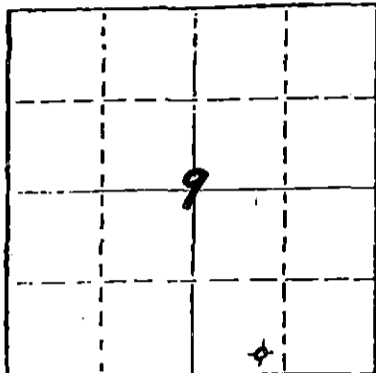

Locate well correctly on above  
Section Plat

Date Well completed November 26, 1980  
Application for plugging filed November 26, 1980  
Application for plugging approved November 26, 1980  
Plugging commenced November 26, 1980  
Plugging completed November 26, 1980  
Reason for abandonment of well or producing formation  
Dry Hole

If a producing well is abandoned, date of last production  
19

Was permission obtained from the Conservation Division or  
its agents before plugging was commenced? Yes

Name of Conservation Agent who supervised plugging of this well Wm. T. Owen  
Producing formation \_\_\_\_\_ Depth to top \_\_\_\_\_ Bottom \_\_\_\_\_ Total Depth of Well 4045'  
Show depth and thickness of all water, oil and gas formations.

OIL, GAS OR WATER RECORDS

CASING RECORD

FORMATION	CONTENT	FROM	TO	SIZE	PUT IN	PULLED OUT
		0'	317'	8-5/8"	310.57'	None

Describe in detail the manner in which the well was plugged, indicating where the mud fluid was placed and the method or methods used in introducing it into the hold. If cement or other plugs were used, state the character of same and depth placed, from \_\_\_\_\_ feet to \_\_\_\_\_ feet for each plug set.

Plugged with 50 sacks cement at 500';  
30 sacks cement at 300'; plug and 10 sacks  
cement at 40'; and 10 sacks cement in  
rat hole.

12-8-80


(If additional description is necessary, use BACK of 316 sheet)  
Name of Plugging Contractor Allied Cementing Co.

CONSERVATION DIVISION  
Wichita, Kansas

STATE OF KANSAS COUNTY OF SEDGWICK, ss.  
John D. Knightley, Agent (employee of owner) or (owner or operator)  
of the above-described well, being first duly sworn on oath, says: That I have knowledge of  
the facts, statements, and matters herein contained and the log of the above-described well  
as filed and that the same are true and correct. So help me God.

(Signature) [Signature]  
221 S. Broadway, Suite 400, Wichita, KS 67202  
(Address)

SUBSCRIBED AND SWORN TO before me this 5th day of December, 1980

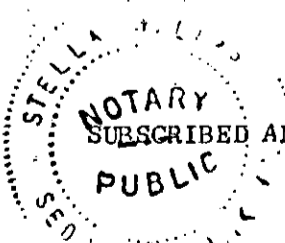

[Signature]  
Notary Public.

My commission expires March 12, 1983

15-185-21160-0000

Oil Properties Co., Inc. -  
Box 335  
Andover, Kansas 67002

R. J. Welsch #1  
NE SW SE Sec. 9-23S-14W  
Stafford County, Kansas

Contractor: D. R. Lauck Oil Company, Inc.  
221 S. Broadway, Suite 400  
Wichita, Kansas 67202

Commenced: November 17, 1980  
Completed: November 26, 1980

Drillers Log

Sand & Shale	250
Shale & Red Bed	320
Red Bed	868
Anhydrite	892
Shale	935
Red Bed & Shale	1810
Shale	2010
Shale & Shells	3465
Shale & Lime	3735
Lime	3787
Shale & Lime	3830
Lime	3960
Shale & Sand	3994
Lime	4045 RTD

RECEIVED  
COMMISSION  
DEC - 8 1980  
CONSERVATION DIVISION  
Wichita, Kansas