


Give All Information Completely
Make Required Affidavit
Mail or Deliver Report to:
Conservation Division,
State Corporation Commission
800 Bittling Building
Wichita, Kansas

WELL PLUGGING RECORD

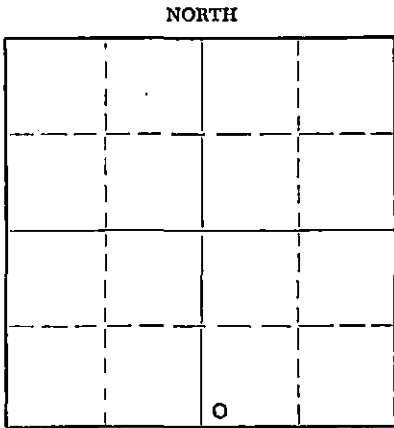

Locate well correctly on above Section Plat

Stafford County, Sec. 12 Twp. 23S Rge. 14 (E) (W)
Location as "NE/CNW/SW" or footage from lines SW SW SE
Lease Owner Petroleum, Inc.
Lease Name Osborne Estate 'A' Well No. 1
Office Address 305 East Third, Wichita 2, Kansas
Character of Well (completed as Oil, Gas or Dry Hole) Dry Hole
Date well completed March 29, 1953
Application for plugging filed March 29, 1953
Application for plugging approved March 29, 1953
Plugging commenced March 29, 1953
Plugging completed March 29, 1953
Reason for abandonment of well or producing formation Dry Hole

If a producing well is abandoned, date of last production 19
Was permission obtained from the Conservation Division or its agents before plugging was commenced? Yes

Name of Conservation Agent who supervised plugging of this well Mr. M. A. Rives, Pratt, Kansas
Producing formation Depth to top Bottom Total Depth of Well 3990 Feet
Show depth and thickness of all water, oil and gas formations.

OIL, GAS OR WATER RECORDS

CASING RECORD

FORMATION	CONTENT	FROM	TO	SIZE	PUT IN	PULLED OUT
				8 5/8"	221'	None

Describe in detail the manner in which the well was plugged, indicating where the mud fluid was placed and the method or methods used in introducing it into the hole. If cement or other plugs were used, state the character of same and depth placed, from feet to feet for each plug set.

Mudded up to 210' and set wooden plug at 210'. Cemented and displaced 20 sacks cement through drill pipe onto plug at 210'. Mudded up to 35' and set second wooden plug. Filled hole to bottom of well cellar with 10 sacks cement.

4-3-53

(If additional description is necessary, use BACK of this sheet)

Name of Plugging Contractor Garvey Drilling Company
Address R. R. #2, Great Bend, Kansas

STATE OF KANSAS, COUNTY OF SEDGWICK, ss.
W. W. Fisher (employee of owner) of the above-described well, being first duly sworn on oath, says: That I have knowledge of the facts, statements, and matters herein contained and the log of the above-described well as filed and that the same are true and correct. So help me God.

(Signature) W. W. Fisher
305 East Third, Wichita, Kansas
(Address)

SUBSCRIBED AND SWORN TO before me this 2nd day of April, 1953

My commission expires October 13, 1954

Charlotte Friedman
Notary Public.

PLUGGING
FILE SEC 12 T 23 R 14 W
BOOK PAGE 88 LINE 27

DRILLER'S LOG OSBORNE EST. A #1

Petroleum, Inc., Operator
Garvey Drilling Company, Contractor
Drilling Commenced: March 17, 1953
Drilling Completed: March 29, 1953
Casing Record: 8 5/8" @ 221' w/225 sax

Section 12, Twp. 23S, Rge. 14W
Location: SW SW SE
County: Stafford County, Kansas
R.T.D.: 3990'
Production: D & A

Figures below indicate bottom of formation:

40 Surface Sand
120 Sand & Gravel
221 Shale & Red Rock
802 Red Bed & Sand
828 Anhydrite
1660 Shale & Shells
3572 Lime & Shale
3737 Lime
3835 Lime & Shale
3895 Lime
3923 Shale & Lime
3954 Shale & Sand
3990 Lime

3990' R.T.D.

Tops:

Heebner: 3353 (-1437)
Brown Line: 3485 (-1569)
Lansing: 3497 (-1581)
Conglomerate: 3826 (-1910)
Viola: 3833 (-1917)
Simpson: 3904 (-1988)
Arbuckle: 3956 (-2040)

I hereby certify that this is a true and correct log of the above mentioned well.

PETROLEUM, INC.

By ww fink

PLUGGING
FILE SEC 12 T 23 R 14W
BOOK PAGE 88 LINE 22

STATE OF KANSAS)
COUNTY OF SEDGWICK)

RECEIVED
STATE CONSERVATION COMMISSION
APR 3 - 1953
CONSERVATION DIVISION
Wichita, Kansas

SS:

Subscribed to and sworn to before me, a Notary Public, in said County and State, this 2nd day of April, 1953.

Charlotte Heidman
Notary Public

My commission expires: October 13, 1954.