

15-185-10942-0000

Form CP-4


STATE OF KANSAS
STATE CORPORATION COMMISSION

WELL PLUGGING RECORD

Give All Information Completely
Make Required Affidavit
Mail or Deliver Report to:
Conservation Division
State Corporation Commission
211 No. Broadway
Wichita, Kansas

Stafford County, Sec. 13 Twp. 23 Rge. 14 (E) W (W)

NORTH

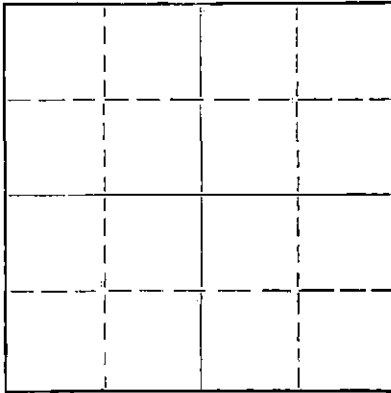

Locate well correctly on above
Section Plat

Location as "NE/CNW/SW" or footage from lines NE SE SE
Lease Owner Texaco, Inc.
Lease Name Malin Well No. 2
Office Address Great Bend, Kansas
Character of Well (completed as Oil, Gas or Dry Hole) _____
Date well completed _____ 19____
Application for plugging filed _____ 19____
Application for plugging approved _____ 19____
Plugging commenced 4-19-65 _____ 19____
Plugging completed 4-22-65 _____ 19____
Reason for abandonment of well or producing formation Depleted.

If a producing well is abandoned, date of last production _____ 19____
Was permission obtained from the Conservation Division or its agents before plugging was commenced? yes

Name of Conservation Agent who supervised plugging of this well Archie Elving
Producing formation _____ Depth to top _____ Bottom _____ Total Depth of Well 4070 Feet
Show depth and thickness of all water, oil and gas formations.

OIL, GAS OR WATER RECORDS

CASING RECORD

FORMATION	CONTENT	FROM	TO	SIZE	PUT IN	PULLED OUT
				10-3/4"	828'	None
				7"	4054'	1392'

Describe in detail the manner in which the well was plugged, indicating where the mud fluid was placed and the method or methods used in introducing it into the hole. If cement or other plugs were used, state the character of same and depth placed, from _____ feet to _____ feet for each plug set.

Checked hole to plug back @ 3993', sanded hole to 3500' and dumped 5 sacks of cement @ 3500' with dump bailer. Pulled 7" casing, checked fluid to 800', mudded hole to 275', set rock bridge to 265' and dumped 30 sacks of cement @ 265'. Mudded hole to ~~300~~ 40', set rock bridge to 30' and ran 10 sacks of cement to base of cellar.

4-28-65

RECEIVED
STATE CORPORATION COMMISSION

APR 28 1965

PLUGGING COMPLETE.

CONSERVATION DIVISION
Wichita, Kansas

(If additional description is necessary, use BACK of this sheet)
Name of Plugging Contractor KNIGHT CASING PULLING COMPANY
Address CHASE, KANSAS

STATE OF KANSAS COUNTY OF RICE, ss.
Noel J. Knight (employee of owner) or (owner or operator) of the above-described well, being first duly sworn on oath, says: That I have knowledge of the facts, statements, and matters herein contained and the log of the above-described well as filed and that the same are true and correct. So help me God.

(Signature) Noel J. Knight
Chase, Kansas
(Address)

SUBSCRIBED AND SWORN TO before me this 26th day of April, 1965

My commission expires May 20, 1968

Milton J. Volin
Notary Public.

15-185-10942 0000

The Texas Company
Tulsa, Oklahoma

Tulsa, Oklahoma
August 16, 1955

CONTRACTOR: Stickle Drilling Company
Drilling Commenced: July 28, 1955
Drilling Completed: August 12, 1955

T.A. Malin #2 NE SE
SE Sec. 13-23S-14W,
Stafford County, Ks.

DRILLERS LOG

Sand & Shale	0-140
Shale	140-235
Sand	235-350
Shale & Shells	350-460
Red Rock	460-818
Anhydrite	818-860
Shale & Shells	860-1690
Lime & Shale	1690-1930
Lime	1930-2115
Lime & Shale	2115-2385
Shale & Lime	2385-2689
Shale & Shells	2689-2835
Shale & Lime	2835-3014
Lime & Shale	3014-3107
Lime	3107-3185
Lime & Shale	3185-3345
Lime	3345-3433
Shale & Lime	3433-3500
Lime	3500-3562
Lime & Shale	3562-3615
Lime	3615-3783
Lime & Shale	3783-3860
Cherty Lime & Shale	3860-3880
Chert & Lime	3880-3913
Chat	3913-3927
Simpson & Shale	3927-3938
Lime	3938-4010
Arbuckle Dolomite	4010-4068
Lime	4068-4090 TD

I, Frank E. Stickle hereby certify the above to be a true and complete Drillers Log of The Texas Company's T. A. Malin #2 NE SE SE Section 13-23S-14W, Stafford County, Kansas.

Frank E. Stickle
Frank E. Stickle

Lillian T. Bonbarr
Notary Public

February 13, 1956
My Commission Expires