


15-185-21633-0000

WELL PLUGGING RECORD

Give All Information Completely  
 Make Required Affidavit

COUNTY Stafford SEC. 14 TWP. 23 RGE. 14 E/W  
 Location as in quarters or footage from lines:  
C/S2 - SE - NW

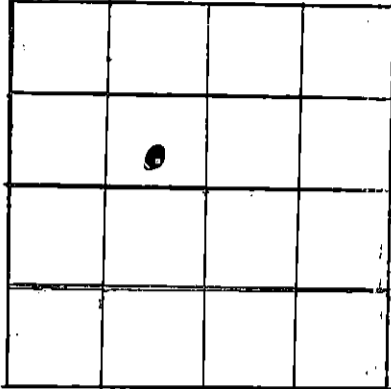

Locate Well  
 correctly on above  
 Section Platt.

Lease Owner Hupfer Oil & Gas  
 Lease Name Roohms Well No. #1  
 Office Address 3711 Country Lane, Hays, Kansas 67601  
 Character of Well (Completed as Oil, Gas or Dry Hole): D&A  
 Date Well Completed 11-11-82  
 Application for plugging filed Yes, attached.  
 Plugging commenced 11:15 a.m. Nov. 11, 1982  
 Plugging completed 2:30 p.m. Nov. 11, 1982  
 Reason for abandonment of well or producing formation  
Production non-commercial.

Was permission obtained from the Conservation Division or it's  
 Agent's before plugging was commenced? Yes

Name of Conservation Agent who supervised plugging of this well J.H. Metz

Producing formation Lansing Depth to top 3591 bottom 3644 T.D. 3991

Show depth and thickness of all water, oil and gas formations. Perforated Lansing 3591-3594  
 and 3644 to 3652.

OIL, GAS OR WATER RECORDS Casing Record

Formation	Content	From	To	Size	Put in	Pulled Out
Shale/Sand	Surface	0	378	8 5/8	378	None
Shale/Lime	Production	0	3985	5 1/2	3985	3110 ft.

Describe in detail the manner in which the well was plugged, indicating where the mud  
 fluid was placed and the method or methods used in introducing it into the hold. If cement  
 or other plugs were used, state the character of same and depth placed, from 3580 feet  
 to 0 feet for each plug set. Hole full of mud & water.

- 1) Set wire line Bridge Plug @ 3580
- 2) 3 sxs. hulls.
- 3) 50 sxs. cement.
- 4) 25 sxs. gel.
- 5) 1 sx. hull.
- 6) 120 sx. cement.

Used Pump truck and shut in @ 150 P.S.I.

(If additional description is necessary, use BACK of this sheet)

Name of Plugging Contractor Allied Cementing P.O. Box 31 Russell, Kansas 67665

STATE OF Kansas COUNTY OF Ellis, ss.

Dennis D. Hupfer (employee of owner) or (owner or operator) of the  
 above-described well, being first duly sworn on oath, says: That I have knowledge of the  
 facts, statements, and matters herein contained and the log of the above-described well as  
 filed and that the same are true and correct. So help me God.

STATE CORPORATION COMMISSION  
 RECEIVED  
 DEC 20 1982

(Signature) Dennis D. Hupfer  
3711 Country Lane, Hays, KS  
 (Address) 67601

SUBSCRIBED AND SWORN TO before me this 17 day of December, 19 82

Shari L. Baird  
 Notary Public.

My Commission expires: March 13, 1986