

WELL PLUGGING RECORD

Give All Information Completely
Make Required Affidavit
Mail or Deliver Report to:
Conservation Division
State Corporation Commission
211 No. Broadway
Wichita, Kansas

Kearny County. Sec. 9 Twp. 21 Rge. 35W (E) (W)

Location as "NE/CNW/SW" or footage from lines NW-NW-SE

Lease Owner R. W. Lange

Lease Name Lange-Campbrll Well No. 1

Office Address R. W. Lange Box 1034 Garden City, Kansas

Character of Well (completed as Oil, Gas or Dry Hole) Oil Well

Date well completed 19

Application for plugging filed 7-2 19 64

Application for plugging approved 7-15 19 64


Plugging commenced 7-16 19 64

Plugging completed 7-17 19 64

Reason for abandonment of well or producing formation Too much Water

If a producing well is abandoned, date of last production 19

Was permission obtained from the Conservation Division or its agents before plugging was commenced? Yes

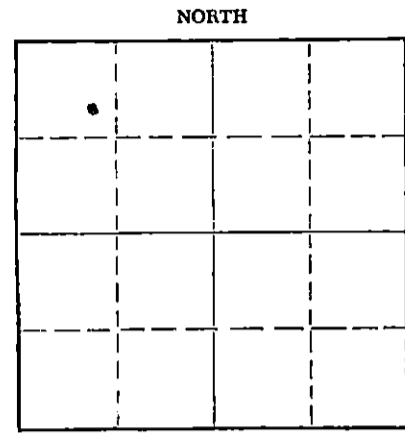

Locate well correctly on above Section Plat

Name of Conservation Agent who supervised plugging of this well Hugh Scott

Producing formation _____ Depth to top _____ Bottom _____ Total Depth of Well 5035 Feet

Show depth and thickness of all water, oil and gas formations.

OIL, GAS OR WATER RECORDS

CASING RECORD

FORMATION	CONTENT	FROM	TO	SIZE	PUT IN	PULLED OUT
				8 5/8	347	None
				4 1/2		2183

Describe in detail the manner in which the well was plugged, indicating where the mud fluid was placed and the method or methods used in introducing it into the hole. If cement or other plugs were used, state the character of same and depth placed, from _____ feet to _____ feet for each plug set.

To plug bottom - Fill hole with mud to 2750. Mix 20 sacks of cement to plug perforations at 2718. Stop plug at 2600 feet. Mud to 340 and pump 35 sacks cement. Mud to 45 feet and 15 sacks cement 45' to 0'. Cut 8 5/8 off 3 feet below ground level and weld metal cap on same.

7-28-64

RECEIVED
STATE CORPORATION COMMISSION

JUL 28 1964

CONSERVATION DIVISION
Wichita, Kansas

(If additional description is necessary, use BACK of this sheet)

Name of Plugging Contractor Sargent's Casing Pulling Service

Address Box 506 Liberal, Kansas

STATE OF _____, COUNTY OF _____, ss.

_____ (employee of owner) or (owner or operator) of the above-described well, being first duly sworn on oath, says: That I have knowledge of the facts, statements, and matters herein contained and the log of the above-described well as filed and that the same are true and correct. So help me God.

(Signature) *R. W. Lange*

(Address)

SUBSCRIBED AND SWORN TO before me this 27 day of July, 19 64

My commission expires Jan 25, 1966
Georgia C. Brown Notary Public.