


STATE OF KANSAS
STATE CORPORATION COMMISSION

WELL PLUGGING RECORD

Give All Information Completely
Make Required Affidavit
Mail or Deliver Report to:
Conservation Division
State Corporation Commission
211 No. Broadway,
Wichita, Kansas

Kearney County, Sec. 9 Twp. 21 S Rge. - (E) 35 (W)

Location as "NE/CNW/SW" or footage from lines NW-NW-SE
Lease Owner The Pure Oil Company
Lease Name Campbell, E. W. Well No. 1
Office Address P. O. Box #271, Tulsa 2, Oklahoma
Character of Well (completed as Oil, Gas or Dry Hole) Dry Hole
Date well completed June 1 19 59
Application for plugging filed (telephoned) June 1 19 59
Application for plugging approved (telephoned) June 1 19 59
Plugging commenced June 1 19 59
Plugging completed June 1 19 59
Reason for abandonment of well or producing formation Dry Hole

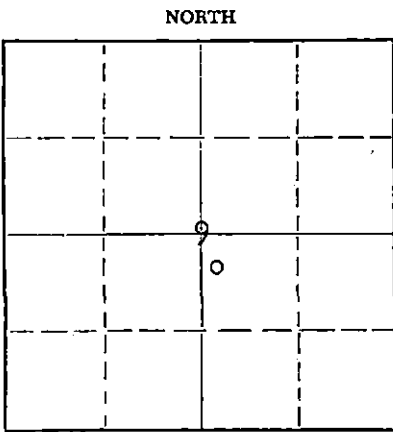

Locate well correctly on above Section Plat

If a producing well is abandoned, date of last production - 19 -
Was permission obtained from the Conservation Division or its agents before plugging was commenced? Yes

Name of Conservation Agent who supervised plugging of this well (telephoned) Mr. Brock
Producing formation None Depth to top - Bottom - Total Depth of Well 5035 Feet
Show depth and thickness of all water, oil and gas formations.

OIL, GAS OR WATER RECORDS

CASING RECORD

FORMATION	CONTENT	FROM	TO	SIZE	PUT IN	PULLED OUT
Herrington	water	2602	2666	8-5/8"	346'	None
Winfield	"	2666	3986			
Lansing	"	3986	4482			
Marmaton	"	4482	4810			
Morrow	"	4810	4865			
Mississippian	"	4865	5035			

Describe in detail the manner in which the well was plugged, indicating where the mud fluid was placed and the method or methods used in introducing it into the hole. If cement or other plugs were used, state the character of same and depth placed, from _____ feet to _____ feet for each plug set.

Dry Hole - Hole full of rotary mud - Spotted 20 sx. cement 335-285 and mudded hole 285-35. Spotted 15 sx. cement 35' to top of surface casing - Screwed steel cap on top of 8-5/8" surface casing to complete abandonment.

6-4-58
RECEIVED
STATE CORPORATION COMMISSION
JUN 4 1959
CONSERVATION DIVISION
Wichita, Kansas

(If additional description is necessary, use BACK of this sheet)
Name of Plugging Contractor Capitt Drilling, Inc. (Drilling Contractor)
Address 814 Union Center, Wichita 2, Kansas

STATE OF Oklahoma, COUNTY OF Tulsa, ss.
I, H. E. Schafer (employee of owner) or (owner or operator) of the above-described well, being first duly sworn on oath, says: That I have knowledge of the facts, statements, and matters herein contained and the log of the above-described well as filed and that the same are true and correct. So help me God.

(Signature) H. E. Schafer *H. E. Schafer* Div. Supt. of Prod.
P. O. Box #271, Tulsa 2, Oklahoma (Address)

SUBSCRIBED AND SWORN to before me this 2nd day of June, 19 59

My commission expires September 9, 1962

W. H. Brown
Notary Public.

PLUGGING
FILE SEC 9 T. 21 R. 35W
BOOK PAGE 42 LINE 43

ROTARY DRILLING LOG

OPERATOR: The Pure Oil Company
E. W. Campbell No. 1
NW NW SE Sec. 9-21S-35W,
Kearney County, Kansas

CONTRACTOR: Capitt Drilling, Inc.
COMM: 5/10/59
COMP: 6/1/59

Remarks: Set 8-5/8" surface casing
at 346' cemented with 300
sacks Pozmix, 2% C.C.

Formations:

Clay, Sand & shale	300'
Shale	960'
Shale & Red Rock	1350'
Shale w/Lime Streaks	1430'
Shale & Lime Streaks	2040'
Shale & Shells	2230'
Lime	2257'
Lime & Shale Streaks	2420'
Shale	2505'
Lime & Shale	2635'
Lime	2798'
Lime & Sand Streaks	2810'
Sandy Lime & Sand	2867'
Lime	2997'
Lime & Shale	3200'
Lime & Shale Streaks	3250'
Lime	3265'
Lime & Shale	3300'
Lime	3730'
Chalky Lime	3823'
Lime	5035'
Rotary Total Depth (D&A)	5035'

We certify the above log is true
and correct to the best of our
knowledge and belief.

CAPITT DRILLING, INC.

R. R. McNicol
R. R. McNicol

RECEIVED
STATE CORPORATION COMMISSION
JUN 6 1959
CONSERVATION DIVISION
Topeka, Kansas

PLUGGING	
FILE	SEC 9 T. 21 R. 35W
BOOK	PAGE 42 LINE 43