

STATE OF KANSAS  
STATE CORPORATION COMMISSION  
130 S. Market, Room 2078  
Wichita, KS 67202

WELL PLUGGING RECORD  
K.A.R.-82-3-117

API NUMBER 15-093-21380-00-00

RECEIVED  
APR 29 2002

TYPE OR PRINT  
NOTICE: Fill out completely  
and return to Cons. Div.  
office within 30 days.

LEASE NAME Hampton Estate

WELL NUMBER 1-9

4,290 Ft. from S Section Line

1,650 Ft. from E Section Line

SEC. 9 TWP. 21 RGE. 35 (E) or (W)

COUNTY Kearny

Date Well Completed 9/30/94

Plugging Commenced 4-4-02

Plugging Completed 4-4-02

KCC WICHITA

LEASE OPERATOR Fremont Exploration, Inc.

ADDRESS 12412 St. Andrews Drive OKC OK 73120

PHONE (405) 936-0012 OPERATORS LICENSE NO. 31790

Character of Well oil

(Oil, Gas, D&A, SWD, Input, Water Supply Well)

The plugging proposal was approved on 4-2-02 (date)

by Jim Holland (KCC District Agent's Name)

Is ACO-1 filed? yes If not, is well log attached? no, none received when Fremont purchased this well from Chesapeake.

Producing Formation Marmaton Depth to Top 4,492' Bottom 4,582' T.O. 5,000'

Show depth and thickness of all water, oil and gas formations.

OIL, GAS OR WATER RECORDS

CASING RECORD

Formation	Content	From	To	Size	Put in	Pulled out
				<u>8 5/8</u>	<u>1930</u>	<u>-</u>
				<u>4 1/2</u>	<u>4892</u>	<u>-</u>

Describe in detail the manner in which the well was plugged, indicating where the mud fluid was placed and the method or methods used in introducing it into the hole. If cement or other plug were used, state the character of same and depth placed, from feet to feet each so Mixed 4 5x hulls & 20 5x cmt. to plug perf's from 4492 to 4292, mud spacer to 1100, mixed 90 5x cmt from 1100 to 0. Mixed 15 5x down annulus from 60 to 0 & press up.

Name of Plugging Contractor SARGENT AND HORTON PLUGGING, INC. License No. 31151

Address Route 1, Box 49BA Tyrone, OK 73951-9731 (580) 854-6515

NAME OF PARTY RESPONSIBLE FOR PLUGGING FEES: Fremont Exploration, Inc.

STATE OF OKLAHOMA COUNTY OF OKLAHOMA, ss.

Thomas O. Goldsworthy, CEO of Fremont Exploration, Inc. (Employee of Operator) or (Operator) above-described well, being first duly sworn on oath, says: That I have knowledge of the fact statements, and matters herein contained and the log of the above-described well as filed in the same are true and correct, so help me God.

(Signature) Thomas O. Goldsworthy

(Address) 12412 ST. ANDREWS DR. OKLAHOMA CITY, OK 73120

SUBSCRIBED AND SWORN TO before me this 25<sup>th</sup> day of April, 2002

Debbie Gordon Notary Public

My Commission Expires 9-26-04  
DEBBIE GORDON  
Notary Public in and for  
State of Oklahoma  
My commission expires Sept. 26, 2004.

HAMPTON ESTATE # 1-9


RECEIVED

JAN 04 2002

KCC WICHITA

Sec 9-21S-35W  
Kearny Cnty, KS

15.093.21380-0000

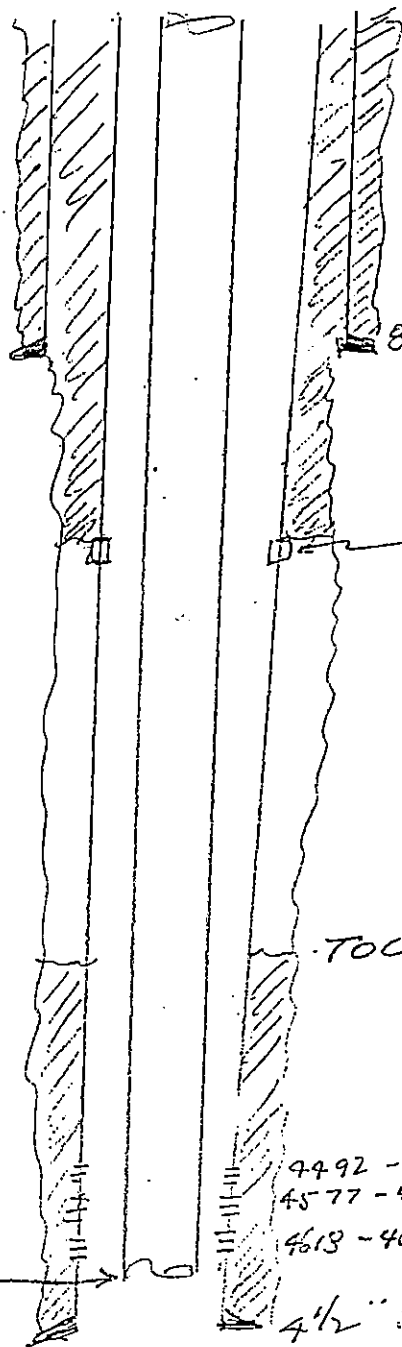

8 5/8" Set at 1930'

Port collar @ 2302' Cement  
with 550 SX POZ MIX/CLASS C  
with 6% gel-calc. fill up  
to surface with excess

TOC 3840' (CALC.)

- 4492 - 4496 Perf
- 4577 - 4581 Perf
- 4613 - 4620 Perf

2 3/8" Tubing @ 4794'

4 1/2" Set at 4842'  
Cement with 225 SX CLASS C

Tom Conroy  
Fremont Exploration Finc.  
12412 St. Andrews Drive  
OK City, OK 73120  
405-936-0012

DON HORTON  
Fax 580-854-6406

Fax 405-936-0015