

STATE OF KANSAS
STATE CORPORATION COMMISSION

WELL PLUGGING RECORD


Give All Information Completely
Make Required Affidavit
Mail or Deliver Report to:
Conservation Division
State Corporation Commission
800 Bittling Building
Wichita, Kansas

OR

FORMATION PLUGGING RECORD

Strike out upper line
when reporting plug-
ging off formations.

NORTH

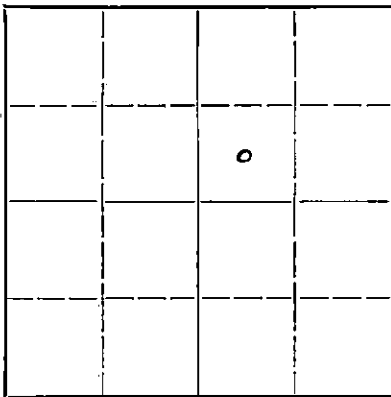

Locate well correctly on above
Section Plat

Finney County. Sec. 34 Twp 21 Rge. 34 (E) 34 (W)
Location as "NE $\frac{1}{4}$ NW $\frac{1}{4}$ SW $\frac{1}{4}$ " or footage from lines C SW $\frac{1}{4}$ NE $\frac{1}{4}$
Lease Owner. The Shallow Water Refining Company
Lease Name. Gobleman "A" Well No. 8
Office Address. 114 West Pine St., Garden City, Kansas
Character of Well (completed as Oil, Gas or Dry Hole). Dry Hole
Date well completed. January 22, 1951
Application for plugging filed. March 30, 1951
Application for plugging approved. March 31, 1951
Plugging commenced. April 7, 1951
Plugging completed. April 16, 1951
Reason for abandonment of well or producing formation. Non-commercial
If a producing well is abandoned, date of last production. - 19
Was permission obtained from the Conservation Division or its agents before plugging was com-
menced? Yes

Name of Conservation Agent who supervised plugging of this well. C. D. Stough
Producing formation. - Depth to top. - Bottom. - Total Depth of Well. 4730 Feet
Show depth and thickness of all water, oil and gas formations.

OIL, GAS OR WATER RECORDS

CASING RECORD

Formation	Content	From	To	Size	Put In	Pulled Out
Herrington	Lime	2513	2522	5 $\frac{1}{2}$ "	4706'	3421'
Lansing - Kansas City	Lime and Shale	3800	4232			
Marmaton	Lime & Shale	4300	4542			
Mississippi	Lime	4633	4730			

Describe in detail the manner in which the well was plugged, indicating where the mud fluid was placed and the method or methods used in introducing it into the hole. If cement or other plugs were used, state the character of same and depth placed, from. feet to feet for each plug set.

Lane Wells plug set at 4333'. Perforated from 4299' to 4307'.

Plugged back from 4333' to 4290'.

Dumped 5 sacks cement.

Mudded hole to 277'.

Set 10' rock bridge.

Ran 15 sacks cement.

Mudded hole to 30'.

Ran 10 sacks cement.

(If additional description is necessary, use BACK of this sheet)

Correspondence regarding this well should be addressed to. The Shallow Water Refining Company
Address. 114 West Pine St.
Garden City, Kansas

STATE OF KANSAS, COUNTY OF FINNEY, ss.
Ben L. Kelley (employee of owner) of the above-described well,
being first duly sworn on oath, says: That I have knowledge of the facts, statements, and matters herein contained and the log of the above-described well as filed and that the same are true and correct. So help me God.

(Signature) Ben L. Kelley
Garden City, Kansas
(Address)

SUBSCRIBED AND SWORN to before me this 26th day of April, 1951.

My commission expires June 1, 1953

RECEIVED
STATE CORPORATION COMMISSION
Notary Public.

22-237 7-47-10M

APR 27 1951 4-27-51

CONSERVATION DIVISION
Wichita, Kansas

PLUGGING
FILE SEC 34 T 21 R 34 W
BOOK PAGE 70 LINE 38

W E L L L O G

Gobleman "A" No. 8

C SW $\frac{1}{4}$ NE $\frac{1}{4}$ Section 34-21S-34W, Finney County, Kansas

Commenced - 12-8-50

Elevation - 2950'

Completed - 12-31-50

Contractor - Pabco Drilling, Inc.

8 5/8" surface casing set at 274' with 150 sacks Halliburton cement.

5 1/2" casing set at 4683' with 125 sacks Halliburton cement.

<u>Formation</u>	<u>From</u>	<u>To</u>
Surface clay & sand	0	40
Sand, shale & shells	40	95
Sand	95	115
Shale & shells	115	175
Shale	175	540
Sand	540	560
Shale & sand	560	650
Shale & shells	1650	1115
Sand	1115	1160
Shale & shells	1160	1440
Anhydrite	1440	1555
Shale & shells	1555	1800
Shale & salt	1800	1985
Shale & redbed	1985	2025
Anhydrite	2025	2050
Shale & shells	2050	2215
Shale & lime	2215	2355
Lime	2355	3238
Shale & lime	3238	3328
Lime	3328	3714
Lime & shale	3714	3790
Lime	3790	3830
Lime & shale	3830	4181
Lime	4181	4219
Lime & shale	4219	4418
Shale & lime	4418	4616
Shale	4616	4625
Shale & lime	4625	4638
Lime	4638	4669
Lime (Coring)	4669	4730
Total Depth		4730

STATE OF KANSAS)
COUNTY OF FINNEY) SSI hereby certify that the above Well Log is true and correct,
to the best of my knowledge and belief.Ben L. KelleySubscribed and sworn to before me this 30 day of March, 1951.

My commission expires June 1, 1953.

Arthur Peterson