


WELL PLUGGING RECORD

Give All Information Completely
Make Required Affidavit
Mail or Deliver Report to:
Conservation Division
State Corporation Commission
211 No. Broadway
Wichita, Kansas

Hamilton County, Sec. 23 Twp. 21 Rge. 41 ~~XXX~~ (W)

Location as "NE/CNW/SE/SW" or footage from lines. SE/NW 1980 FWL 2540 FNL
Lease Owner Kansas-Nebraska Natural Gas Co., Inc.
Lease Name Martin Well No. 1
Office Address 300 N. St. Joseph Street, Hastings, Nebraska
Character of Well (completed as Oil, Gas or Dry Hole) Dry Hole
Date well completed 6-14 19 71
Application for plugging filed Oct. 2 19 72
Application for plugging approved Oct. 12 19 72
Plugging commenced 11-10 19 72
Plugging completed 11-11 19 72
Reason for abandonment of well or producing formation Excessive Water

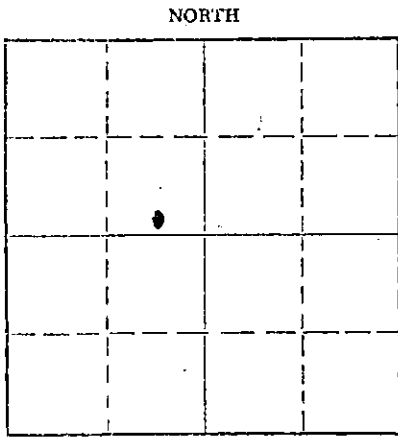

Locate well correctly on above Section Plat

If a producing well is abandoned, date of last production _____ 19 ____
Was permission obtained from the Conservation Division or its agents before plugging was commenced? Yes

Name of Conservation Agent who supervised plugging of this well Ed Eves
Producing formation Winfield Depth to top 2770 Bottom 2784 Total Depth of Well 2796 Feet
Show depth and thickness of all water, oil and gas formations.

OIL, GAS OR WATER RECORDS

CASING RECORD

FORMATION	CONTENT	FROM	TO	SIZE	PUT IN	PULLED OUT
Winfield	Gas & Water	2770	2784	7"	370	None
				4 1/2"	2795	1828

Describe in detail the manner in which the well was plugged, indicating where the mud fluid was placed and the method or methods used in introducing it into the hole. If cement or other plugs were used, state the character of same and depth placed, from _____ feet to _____ feet for each plug set.

Mixed ~~XX~~ one sack cottonseed hulls & 15 sks cement to plug perforations at 2778 700#. Stopped plug at 2595. Plug pumped down with fresh water gel mud. Shot pipe free at 1824. Pulled 4 1/2" to 600'. Pumped 30 sks for plug 600 to 500. Pulled 4 1/2" to 425. Pumped 30 sks for plug 425 to 300 ft. Pulled all 4 1/2" pipe. Put in 10 sks plug 45 ft. to 0.

RECEIVED
STATE CORPORATION COMMISSION

DEC 5 - 1972

CONSERVATION DIVISION
Wichita, Kansas

125-72

(If additional description is necessary, use BACK of this sheet)
Name of Plugging Contractor Sargent Casing Pulling Service
Address Liberal, Kansas

STATE OF KANSAS, COUNTY OF KEARNY, ss.
Lawrence Holmstrom (employee of owner) or (~~owner~~) of the above-described well, being first duly sworn on oath, says: That I have knowledge of the facts, statements, and matters herein contained and the log of the above-described well as filed and that the same are true and correct. So help me God.

(Signature) Lawrence Holmstrom
Lakin, Kansas
(Address)

SUBSCRIBED AND SWORN TO before me this 4th day of December, 19 72

My commission expires Dec. 27, 1973 Olive N. Green Notary Public.

Well file

15-075-20025-0000

CONTRACTOR'S WELL LOG

OPERATOR:	Kansas-Nebraska Natural Gas
CONTRACTOR:	Abercrombie Drilling, Inc.
WELL NAME:	#1 MARTIN "Twin"
LOCATION:	1980' FWL, 1540' FNL Sec. 23-21S-41W, Hamilton Co., Ks.
GEOLOGIST:	
SPUD DATE:	December 6, 1970
COMPLETION DATE:	December 9, 1970

0	100	Clay & Rock
100	373	Shale & Shells
373	1654	Shale
1654	1770	Shale & Lime
1770	2035	Salt
2035	2133	Shale & Lime
2133	2330	Shale
2330	2348	Anhydrite
2348	2400	Shale & Shells
2400	2795	Shale
	2795	Rotary Total Depth

Drilled 373' of 9" surface hole. Set 7" surface @369' w/175 sx. Cement circulated. Plug was down at 10:00 p.m. 12-6-70. Ran log, set 4½" casing at 2795' w/100 sx. pos-mix, plug was down at 11:30 p.m. 12-9-70.

STATE OF KANSAS)
) SS
COUNTY OF SEDGWICK)

RECEIVED
STATE CORPORATION COMMISSION

DEC 12 1970

CONSERVATION DIVISION
Wichita, Kansas

Jerry A. Langrehr, President of Abercrombie Drilling, Inc., does hereby state that the above and foregoing is a true and correct copy of the log of the #1 MARTIN "Twin", 1980' FWL, 1540' FNL, Sec. 23-21S-41W, Hamilton County, Kansas.

ABERCROMBIE DRILLING, INC.

By: Jerry A. Langrehr
Jerry A. Langrehr
President

Subscribed and sworn to before me, a Notary Public, in and for the aforesaid county and state as of this 15th day of December, 1970.

Sue J. McCoy
Sue J. McCoy, Notary Public

My Commission Expires:

November 12, 1973