

STATE OF KANSAS
STATE CORPORATION COMMISSION

WELL PLUGGING RECORD

Give All Information Completely
Make Required Affidavit
Mail or Deliver Report to:
Conservation Division
State Corporation Commission
211 No. Broadway
Wichita, Kansas

Kearny County, Sec. 32 Twp 21 Rge. (E) 35 (W)

Location as "NE/CNW/SW" or footage from lines C SE/4

Lease Owner Excelsior Oil Corporation

Lease Name Miller F Well No. 1

Office Address Box 608, Hastings, Nebraska

Character of Well (completed as Oil, Gas or Dry Hole) Gas

Date well completed 7/28 1959

Application for plugging filed 8/28 1964

Application for plugging approved 8/31 1964


Plugging commenced 9/25 1964

Plugging completed 9/25 1964

Reason for abandonment of well or producing formation No longer capable of commercial production

If a producing well is abandoned, date of last production 8/27 1964

Was permission obtained from the Conservation Division or its agents before plugging was commenced? Yes

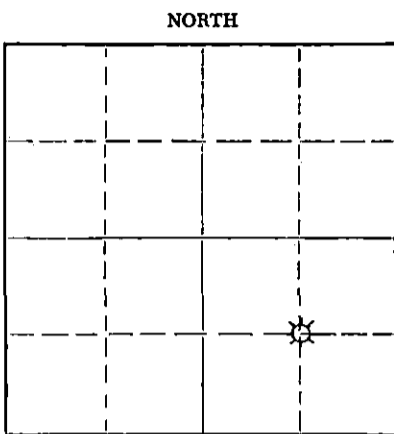

Locate well correctly on above Section Plat

Name of Conservation Agent who supervised plugging of this well Hugh Scott

Producing formation Herrington & Krider Depth to top 2611 Bottom 2673 Total Depth of Well 2675 Feet

Show depth and thickness of all water, oil and gas formations.

OIL, GAS OR WATER RECORDS

CASING RECORD

FORMATION	CONTENT	FROM	TO	SIZE	PUT IN	PULLED OUT
Herrington	Gas	2612	2621	8-5/8	333	None
Krider	Gas	2644	2673	5-1/2	2700	870

Describe in detail the manner in which the well was plugged, indicating where the mud fluid was placed and the method or methods used in introducing it into the hole. If cement or other plugs were used, state the character of same and depth placed, from _____ feet to _____ feet for each plug set.

Mixed 20 sacks cement with pump truck to plug off perforations. Lost cement out perforations.

Mixed 10 sacks and stopped plug at 2521.

Shot pipe loose at 1203 feet. Pulled 870 feet 5-1/2".

Mixed 35 sacks cement with pump truck and pumped down 5-1/2" casing. Plug 333 to 233.

Pulled balance of casing.

Put 15 sacks plug 45 feet to 0.

RECEIVED
STATE CORPORATION COMMISSION

NOV 9 1964

CONSERVATION DIVISION
Wichita, Kansas

11-9-64

(If additional description is necessary, use BACK of this sheet)

Name of Plugging Contractor Sargent's Casing Pulling Co.

Address 121 West 9th Street, Liberal, Kansas

STATE OF Nebraska, COUNTY OF Adams, ss.

S. D. Ford, Jr. (employee of owner) or (owner or operator) of the above-described well, being first duly sworn on oath, says: That I have knowledge of the facts, statements, and matters herein contained and the log of the above-described well as filed and that the same are true and correct. So help me God.

(Signature) [Signature]

P. O. Box 608, Hastings, Nebraska
(Address)

SUBSCRIBED AND SWORN TO before me this 6th day of November, 1964

January 23, 1970

F. S. WHITE
Notary Public.

My commission expires _____

WELL LOG

15.093-00257-0000

COMPANY KANSAS-NEBRASKA NATURAL GAS COMPANY

SEC. 32 T. 21S R. 35W

FARM F. MILLER

NO. 1

LOC. C-SE/4


TOTAL DEPTH 2705'

COUNTY KEARNY CO., KANSAS

COMM. July 4, 1959

COMP. July 9, 1959

CONTRACTOR GARVEY DRILLING COMPANY

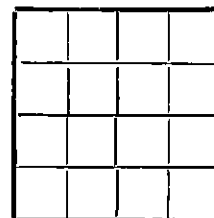

CASING 8 5/8" @ 338' W/225 sax.
5 1/2" @ 2705' W/200 sax.

ELEVATION

PRODUCTION

FIGURES INDICATE BOTTOM OF FORMATIONS

RECEIVED
STATE CORPORATION COMMISSION

NOV 20 1964

CONSERVATION DIVISION
Wichita, Kansas

60	Surface clay
675=	Shale
1390	Shale & shells
1410	Anhydrite
1490	Shale & sand
1640	Shale
1710	Sand
1855	Shale & shells
2155	Shale
2705	Lime & shab
2705	T. D.

State of KANSAS }
County of BARTON } ss:

I, VERNE A. MORRIS of GARVEY DRILLING COMPANY

upon oath state that the above and foregoing is a true and correct copy of the log of the #1 F. MILLER well

Verne A. Morris

Subscribed and sworn to before me this 28th day of July 19 59

My Commission Expires: November 12, 1962

Brantford
NOTARY PUBLIC