


STATE OF KANSAS
STATE CORPORATION COMMISSION

Form CP-4

Give All Information Completely
Make Required Affidavit
Mail or Deliver Report to:
Conservation Division
State Corporation Commission
P. O. Box 17027

WELL PLUGGING RECORD

Wichita, Kansas 67217
NORTH

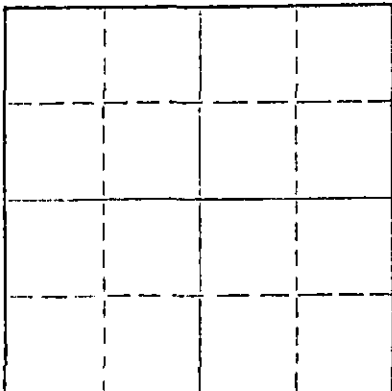

Locate well correctly on above
Section Plat

Kearny County, Sec. 32 Twp. 21S Rge. 35W (E) (W)

Location as "NE/CNW/SE/SW" or footage from lips NE SE

Lease Owner Abercrombie Drilling, Inc.

Lease Name Miller Well No. 1

Office Address 801 Union Center Bldg., Wichita, Kansas

Character of Well (completed as Oil, Gas or Dry Hole) Dry Hole

Date well completed 7-25 1972

Application for plugging filed 7-25 1972

Application for plugging approved 7-25 1972

Plugging commenced 7-25 1972

Plugging completed 7-25 1972

Reason for abandonment of well or producing formation commercial quantity of oil not found

If a producing well is abandoned, date of last production 19

Was permission obtained from the Conservation Division or its agents before plugging was commenced? yes

Name of Conservation Agent who supervised plugging of this well Edgar Eves, Sublette, Kansas

Producing formation _____ Depth to top _____ Bottom _____ Total Depth of Well 5065 Feet

Show depth and thickness of all water, oil and gas formations.

OIL, GAS OR WATER RECORDS

CASING RECORD

FORMATION	CONTENT	FROM	TO	SIZE	PUT IN	PULLED OUT
				8 5/8"	366.10'	

Describe in detail the manner in which the well was plugged, indicating where the mud fluid was placed and the method or methods used in introducing it into the hole. If cement or other plugs were used, state the character of same and depth placed, from _____ feet to _____ feet for each plug set.

Mudded back and set plug at 365' w/35 sx. cement
40' w/15 sx. cement

8-2-72

RECEIVED
STATE CORPORATION COMMISSION
AUG 2 1972
CONSERVATION DIVISION
Wichita, Kansas

(If additional description is necessary, use BACK of this sheet)
Name of Plugging Contractor Rains & Williamson Oil Co., Inc.
Address 435 Page Court Bldg., 220 W. Douglas, Wichita, Kansas

STATE OF KANSAS COUNTY OF SEDGWICK
Wilson Rains, Pres. of Rains & Williamson Oil Co., Inc. ss.

(employee of owner) or (owner or operator) of the above-described well, being first duly sworn on oath, says: That I have knowledge of the facts, statements and matters herein contained and the log of the above-described well as filed and that the same are true and correct. So help me God.

(Signature) Wilson Rains
Wilson Rains
435 Pg. Court Bldg. (Address)

Sworn to before me this 27th day of July 1972



Juanita M. Green
Juanita M. Green Notary Public.

WELL LOG

COMPANY Abercrombie Drilling, Inc.

SEC. 32 T. 21S R. 35W
LOC. NE SE

FARM Miller

NO. 1


RIG. NO. 5

TOTAL DEPTH 5065

COMM. 7-10-72

COMP. 7-25-72

COUNTY Kearny
KANSAS

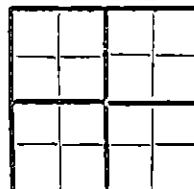

CONTRACTOR Rains & Williamson Oil Co., Inc.
435 Page Court Bldg.
Wichita, Kansas 67202

CASING

20 10
15 8
12 6
10 5

5/8" @ 366.10 w/150 sx. 3% gel,
2% C.C. 1" top w/cem, w/100 sx.

ELEVATION 3143 K.B.

PRODUCTION

FIGURES INDICATE BOTTOM OF FORMATIONS

Sand & Shale	108
Shale w/sd. streaks	310
Shale	369
Shale & Shells	970
Shale	1357
Blaine Anhydrite	1364
Shale	1745
Anhydrite	1815
Shale	2097
Shale & Lime	2360
Lime & Shale	4085
Lime	4940
Mississippi	5010
Mississippi Lime	5065
<u>Rotary Total Depth</u>	<u>5065</u>

RECEIVED
STATE CORPORATION COMMISSION

AUG 2 1972

CONSERVATION DIVISION
Wichita, Kansas

State of KANSAS
County of SEDGWICK ss:

I, Wilson Rains, President of the Rains & Williamson Oil Co., Inc. Company

upon oath state that the above and foregoing is a true and correct copy of the log of the Miller #1 well.

Wilson Rains
Wilson Rains

Subscribed and sworn to before me this 27th day of July 19 72

My Commission Expires: 10-4-75

Juanita M. Green
NOTARY PUBLIC
Juanita M. Green

