


STATE OF KANSAS  
STATE CORPORATION COMMISSION

WELL PLUGGING RECORD

Give All Information Completely  
Make Required Affidavit  
Mail or Deliver Report to  
Conservation Division  
State Corporation Comm.  
245 North Water  
Wichita, KS 67202

Hodgman County, Sec. 17 Twp. 21 Rge. 25 E/W  
Location as "NE/CNW $\frac{1}{4}$ /SW $\frac{1}{4}$ " or footage from lines  
SE SE

Lease Owner National Development Co.  
Lease Name Ruth Jackson A Well No. /  
Office Address Wichita, Kansas  
Character of Well (Completed as Oil, Gas or Dry Hole)

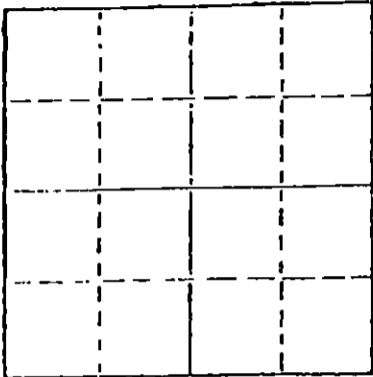

Locate well correctly on above  
Section Plat

Date Well completed 19  
Application for plugging filed 19  
Application for plugging approved 19  
Plugging commenced 1/23/77 19  
Plugging completed 1/27/77 19  
Reason for abandonment of well or producing formation  
depleted.

If a producing well is abandoned, date of last production 19

Was permission obtained from the Conservation Division or  
its agents before plugging was commenced? yes

Name of Conservation Agent who supervised plugging of this well Thomas  
Producing formation Depth to top Bottom Total Depth of Well 4405  
Show depth and thickness of all water, oil and gas formations.

OIL, GAS OR WATER RECORDS

CASING RECORD

FORMATION	CONTENT	FROM	TO	SIZE	PUT IN	PULLED OUT
				8-5/8	311	none
				4 1/2	4399	2403'

Describe in detail the manner in which the well was plugged, indicating where the mud fluid  
was placed and the method or methods used in introducing it into the hold. If cement or other  
plugs were used, state the character of same and depth placed, from feet to  
feet for each plug set.

Pumped 2 sacks hulls, 25 sacks cement on bottom. Shot pipe at 3390', 3203',  
3010', 2815', 2622', 2527', 2396', pulled 74 joints. Plugged well with 50  
sacks cement, 22 sacks gel, 25 sacks cement, 8 sacks gel and 15 sacks cement.

PLUGGING COMPLETE.

RECEIVED  
STATE CORPORATION COMMISSION  
WICHITA, KANSAS

FEB 04 1977

2-4-77

(If additional description is necessary, use BACK of this sheet)  
Name of Plugging Contractor KESLO CASING PULLING  
CHASE, KANSAS


CONSULTING ENGINEER  
Wichita, Kansas

STATE OF KANSAS COUNTY OF RICE, ss.  
R. DARRELL KELSO (employee of owner) or (owner or operator)  
of the above-described well, being first duly sworn on oath, says: That I have knowledge of  
the facts, statements, and matters herein contained and the log of the above-described well  
as filed and that the same are true and correct. So help me God.

(Signature) R. Darrell Kelso  
CHASE, KANSAS  
(Address)

SUBSCRIBED AND SWORN TO before me this 31st day of Jan., 19 77

My commission expires

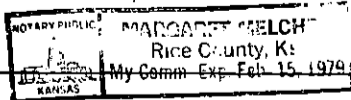

Margaret Melcher  
Notary Public.