


STATE OF KANSAS  
STATE CORPORATION COMMISSION

WELL PLUGGING RECORD

Give All Information Completely.  
Make Required Affidavit  
Mail or Deliver Report to  
Conservation Division  
State Corporation Comm.  
245 North Water  
Wichita, KS 67202

Pawnee County, Sec. 1 Twp. 21 Rge. 16 E/W  
Location as "NE/CNW $\frac{1}{4}$ /SW $\frac{1}{4}$ " or footage from lines \_\_\_\_\_

SW NW SW  
Lease Owner Brougher Oil, Inc.  
Lease Name Barrett "B" Well No. 1  
Office Address Drawer 1367, Great Bend, Kansas 67530  
Character of Well (Completed as Oil, Gas or Dry Hole) \_\_\_\_\_

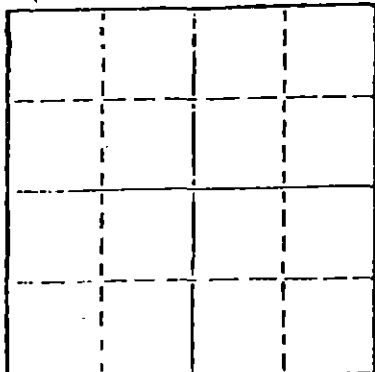

Locate well correctly on above  
Section Plot

dry hole  
Date Well completed Oct. 22 19 80  
Application for plugging filed Oct. 22 19 80  
Application for plugging approved Oct. 22 19 80  
Plugging commenced Oct. 22 19 80  
Plugging completed Oct. 22 19 80  
Reason for abandonment of well or producing formation \_\_\_\_\_

dry hole  
If a producing well is abandoned, date of last production 19 \_\_\_\_\_

Was permission obtained from the Conservation Division or  
its agents before plugging was commenced? yes

Name of Conservation Agent who supervised plugging of this well Leo Massey  
Producing formation \_\_\_\_\_ Depth to top \_\_\_\_\_ Bottom \_\_\_\_\_ Total Depth of Well 3826  
Show depth and thickness of all water, oil and gas formations.

OIL, GAS OR WATER RECORDS

CASING RECORD

FORMATION	CONTENT	FROM	TO	SIZE	PUT IN	PULLED OUT
				8 5/8	987	

Describe in detail the manner in which the well was plugged, indicating where the mud fluid was placed and the method or methods used in introducing it into the hold. If cement or other plugs were used, state the character of same and depth placed, from \_\_\_\_\_ feet to \_\_\_\_\_ feet for each plug set.

1st plug 930 w/60 sx.  
2nd plug 270 w/30 sx.  
3rd plug 40 w/10 sx.  
5 sx in rathole

10-28-80

RECEIVED  
STATE CORPORATION COMMISSION

OCT 28 1980

(If additional description is necessary, use BACK of this sheet)

Name of Plugging Contractor Woodman & Iannitti Drilling Co.

CONSERVATION DIVISION  
Wichita, Kansas

STATE OF KANSAS COUNTY OF SEDGWICK, ss.  
K. T. Woodman (employee of owner) or (owner or operator)  
of the above-described well, being first duly sworn on oath, says: That I have knowledge of the facts, statements, and matters herein contained and the log of the above-described well as filed and that the same are true and correct. So help me God.

(Signature)

1008 Douglas Bldg. 104 So. Broadway  
(Address)

SUBSCRIBED AND SWORN TO before me this 27th day of October, 19 80

My commission expires Feb. 11, 1984

Justina Chamberlain  
Justina Chamberlain Notary Public.

K. T. WOODMAN  
 RES. PHONE 733-0418  
 OFF. PHONE 265-7650  
 WICHITA, KANSAS

D. J. IANNITTI  
 PHONE 792-2921  
 GREAT BEND, KANSAS

## WOODMAN & IANNITTI DRILLING COMPANY

*Rotary Drilling Contractors*

1008 DOUGLAS BUILDING  
 104 S. BROADWAY  
 WICHITA, KANSAS 67202

October 24, 1980

Company;	Brougner Oil, Inc.
Farm;	Barrett "B" #1
Location;	SW NW SW
Section;	1-21-16W
County;	Pawnee
Contractor;	Woodman & Iannitti Drilling Co.
Comm;	October 16, 1980
Compl;	October 22, 1980
Total Depth;	3826
Casing;	8 5/8 @ 987
Production;	D & A

Figures Indicate Bottom Of Formations;

4-9	Shale & shells
522	Dakota sand
640	Shale
975	Shale
988	Anhy
1715	Shale
2050	Shale
3170	Shale & lime
3586	Lime & shale
3686	Lime & shale
3779	Lime
3826	Lime & arbuckle

I certify the above to be a true and correct copy of the drillers log to the best of my knowledge and belief.

Woodman & Iannitti Drilling Co.

*K. T. Woodman*  
 K. T. Woodman

RECEIVED  
 STATE CORPORATION COMMISSION

OCT 28 1980

CONSERVATION DIVISION  
 Wichita, Kansas