


STATE OF KANSAS
STATE CORPORATION COMMISSION

Form CP-4

Give All Information Completely
Make Required Affidavit
Mail or Deliver Report to:
Conservation Division
State Corporation Commission
212 No. Market
Wichita, Kansas

WELL PLUGGING RECORD

NORTH

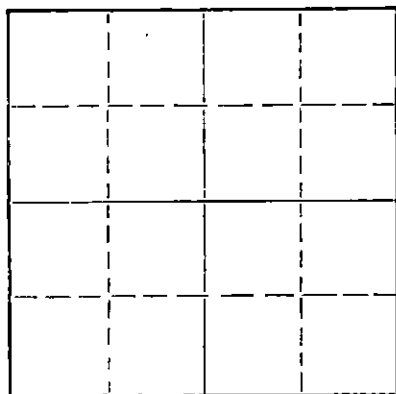

Locate well correctly on above
Section Plat

Pawnee County, Sec. 5 Twp. 21 Rge. 15W (E) (W)
Location as "NE/CNW/SW" or footage from lines E/2 SW SW
Lease Owner Messman & Rinehart Oil Co.
Lease Name Sweeney Well No. c-1
Office Address 1432 Wichita Plaza, Wichita, Kansas
Character of Well (completed as Oil, Gas or Dry Hole) _____
Date well completed _____ 19____
Application for plugging filed July 19 67
Application for plugging approved July 19 67
Plugging commenced July 21 19 67
Plugging completed July 27 19 67
Reason for abandonment of well or producing formation _____

If a producing well is abandoned, date of last production _____ 19____
Was permission obtained from the Conservation Division or its agents before plugging was commenced? Yes

Name of Conservation Agent who supervised plugging of this well Leo Massey
Producing formation _____ Depth to top _____ Bottom _____ Total Depth of Well 3889' Feet
Show depth and thickness of all water, oil and gas formations.

OIL, GAS OR WATER RECORDS

CASING RECORD

FORMATION	CONTENT	FROM	TD	SIZE	PUT IN	PULLED OUT
				5 1/2"		3233'

Describe in detail the manner in which the well was plugged, indicating where the mud fluid was placed and the method or methods used in introducing it into the hole. If cement or other plugs were used, state the character of same and depth placed, from _____ feet to _____ feet for each plug set.

Plugged off bottom of hole with sand. Sand from 3825 to 3695'. Dumped 5 sx of cement. Made rock bridge at 400'. Dumped 5 yards of Ready-Mix Cement, filling to the bottom of the cellar.

7-31-67

RECEIVED
STATE CORPORATION COMMISSIONS

JUL 21 1967

CONSERVATION DIVISION
WICHITA, KANSAS

(If additional description is necessary, use BACK of this sheet)

Name of Plugging Contractor Art Lamb Casing Pulling Co.
Address 2809 King St. Hutchinson, Kansas

STATE OF Kansas, COUNTY OF Reno, ss.
Art Lamb (employee of owner) or (owner or operator) of the above-described well, being first duly sworn on oath, says: That I have knowledge of the facts, statements, and matters herein contained and the log of the above-described well as filed and that the same are true and correct. So help me God.

(Signature) [Signature]
2809 King St. Hutchinson, Kansas
(Address)

SUBSCRIBED AND SWORN TO before me this 28 th day of July, 19 67

My commission expires January 5, 1970

[Signature]
Notary Public.

NO. 1 SWEENEY "C"

WELL RECORD

Location: Ctr E/2 SW SW, 5-21S-15W
Pawnee County, Kansas

Commenced: December 31, 1954

Operator: Graham-Messman-Rinehart Drilling Co.
Box 1033, Wichita, Kansas

Completed: January 12, 1954

Contractor: Graham-Messman-Rinehart Drilling Co.
Box 1033, Wichita, Kansas

Elevation: 1961 KB

Casing Record: 8 5/8" @ 964' w/400 sacks cement
5 1/2" @ 3889' w/100 sacks cement

Production:

....L O G....

Sand	73
Sand-Clay	190
Shale	365
Sand	480
Red Bed-Shale	950
Anhydrite	964
Shale	1180
Shale-Shells	1475
Salt	1670
Shale-Lime	1840
Lime-Shale	2235
Shale-Lime	2350
Shale-Shells	2385
Lime-Shale	2470
Shale-Lime	2595
Lime-Shale	2820
Lime	3040
Lime-Shale	3255
Lime	3310
Lime-Shale	3450
Lime	3502
Lime, Porous	3521
Lime	3625
Shale-Lime	3730
Conglomerate	3742
Simpson Shale	3774
Arbuckle	3783
Coring	3889 R.T.D.

Sample Tops:

Log Tops:

Heebner 3311 (-1350)	Congl. 3684 (-1807)
Brn Lime 3405 (-1444)	Simpson 3729 (-1768)
Lansing 3418 (-1457)	Arbuckle 3768 (-1807)
Conglomerate 3693 (-1732)	
Viola 3718 (-1757)	
Simpson 3731 (-1770)	
Arbuckle 3769 (-1808)	

The undersigned, GRAHAM-MESSMAN-RINEHART DRILLING COMPANY, hereby certifies that the above log is a true and correct log of the formation encountered in drilling the above well as reflected by the Daily Drilling Report.

GRAHAM-MESSMAN-RINEHART DRILLING COMPANY

By: J. A. Gilliland
J. A. Gilliland

Subscribed and sworn to before me this 28th day of January 1955.

Janita L. Lewis
Notary Public

My Commission Expires: November 5, 1958

GMR
File Copy