


STATE OF KANSAS
STATE CORPORATION COMMISSION

WELL PLUGGING RECORD

Give All Information Completely
Make Required Affidavit
Mail or Deliver Report to:
Conservation Division
State Corporation Commission
211 No. Broadway
Wichita, Kansas

NORTH

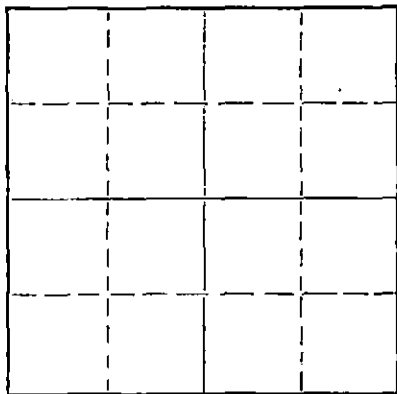

Locate well correctly on above
Section Plat

Pownee County. Sec. 5 Twp. 21 Rge. 15 (E) W. (W)
Location as "NE/CNW/SW" or footage from lines NE NW SW
Lease Owner Fender Pipe & Supply
Lease Name Speier Well No. 2
Office Address Russell, Kansas
Character of Well (completed as Oil, Gas or Dry Hole) _____
Date well completed _____ 19____
Application for plugging filed _____ 19____
Application for plugging approved _____ 19____
Plugging commenced Oct. 13 1965
Plugging completed Nov. 3 1965
Reason for abandonment of well or producing formation _____

If a producing well is abandoned, date of last production _____ 19____
Was permission obtained from the Conservation Division or its agents before plugging was commenced? Yes

Name of Conservation Agent who supervised plugging of this well Liker
Producing formation _____ Depth to top _____ Bottom _____ Total Depth of Well 3860 Feet
Show depth and thickness of all water, oil and gas formations.

OIL, GAS OR WATER RECORDS

CASING RECORD

FORMATION	CONTENT	FROM	TO	SIZE	PUT IN	PULLED OUT

Describe in detail the manner in which the well was plugged, indicating where the mud fluid was placed and the method or methods used in introducing it into the hole. If cement or other plugs were used, state the character of same and depth placed, from 3860 feet to surface feet for each plug set.

Sanded up to 3800' dump 4 sacks of cement on bottom. Pulled pipe out pump 15 sacks of mud & 100 sacks of cement in hole.
Well completed.

12-8-65

RECEIVED
STATE CORPORATION COMMISSION

DEC - 8 1965

CONSERVATION DIV. STATE
WICHITA, KANSAS

(If additional description is necessary, use BACK of this sheet)

Name of Plugging Contractor Barnes & Sons Pipe Pulling Co.
Address P.O. Box 313 Russell, Kansas

STATE OF Kansas, COUNTY OF Russell, ss.
Allen J. Fenders (employee of owner) or (owner or operator) of the above-described well, being first duly sworn on oath, says: That I have knowledge of the facts, statements, and matters herein contained and the log of the above-described well as filed and that the same are true and correct. So help me God.

(Signature) Allen J. Fenders

Box 302 Russell, Kansas
(Address)

SUBSCRIBED AND SWORN TO before me this 7th day of December, 1965

My commission expires September 27, 1967
Delma Underwood Notary Public.