


STATE OF KANSAS
STATE CORPORATION COMMISSION

WELL PLUGGING RECORD

Give All Information Completely
Make Required Affidavit
Mail or Deliver Report to:
Conservation Division
State Corporation Commission
800 Bitting Building
Wichita, Kansas

Pawnee County. Sec. 8 Twp. 21S Rge. (E) 15 (W)
Location as "NE/CNW/SE" or footage from lines Ctr W/2 SW SE
Lease Owner Graham-Messman-Rinehart Drilling Company
Lease Name Sweeny "B" Well No. 1
Office Address 1005 East Second, Wichita, Kansas
Character of Well (completed as Oil, Gas or Dry Hole) Gas
Date well completed January 7, 1955 19
Application for plugging filed March 26, 1956 19
Application for plugging approved March 26, 1956 19
Plugging commenced April 16, 1956 19
Plugging completed April 19, 1956 19
Reason for abandonment of well or producing formation Production decreased until
no longer commercial.
If a producing well is abandoned, date of last production October 8 19 55
Was permission obtained from the Conservation Division or its agents before plugging was com-
menced? Yes

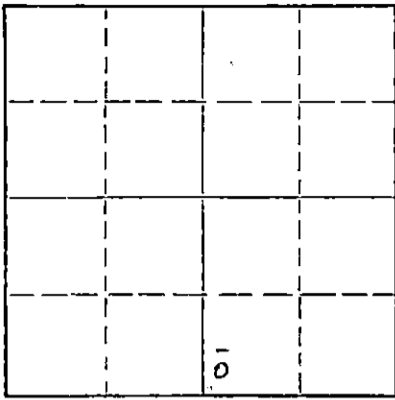

Locate well correctly on above
Section Plat

Name of Conservation Agent who supervised plugging of this well R. M. Brundage, Hoisington
Producing formation Arbuckle Depth to top 3802 Bottom 3860 Total Depth of Well 3860 Feet
Show depth and thickness of all water, oil and gas formations.

OIL, GAS OR WATER RECORDS

CASING RECORD

FORMATION	CONTENT	FROM	TO	SIZE	PUT IN	PULLED OUT
				8 5/8"	946	None
				5 1/2"	3850	2408

Describe in detail the manner in which the well was plugged, indicating where the mud fluid was placed and the method or methods used in introducing it into the hole. If cement or other plugs were used, state the character of same and depth placed, from _____ feet to _____ feet for each plug set.

Plugged back with crushed rock to 3795. Dumped 5 sacks cement at 3795 with dump bailer. Top of cement 3690'. Filled hole with mud to 400', set rock bridge, dumped 20 sacks cement. Top of cement 340'. Filled hole with mud to 35'. Set rock bridge, dumped 10 sacks cement for cap.

MAILED
MAY 1 1956

5-1-56

CONSERVATION DIVISION
Wichita, Kansas

(If additional description is necessary, use BACK of this sheet)

Name of Plugging Contractor Miller Casing Pulling Company (License No. 12)
Address P. O. Box 711, Great Bend, Kansas

STATE OF Kansas, COUNTY OF Sedgwick, ss.
J. A. Gilliland (employee of owner) or (~~owner or operator~~) of the above-described well, being first duly sworn on oath, says: That I have knowledge of the facts, statements, and matters herein contained and the log of the above-described well as filed and that the same are true and correct. So help me God!

(Signature) J. A. Gilliland
1005 East Second, Wichita, Kansas
(Address)

SUBSCRIBED AND SWORN to before me this 26th day of April, 1956

Juanita L. Davis
Notary Public.

My commission expires November 5, 1958

PLUGGING
FILED SEC 8 T 21 R 15W
BOOK PAGE 48 LINE 27

PLUGGING
 SEC 8 12 15W
 BOOK PAGE 48 LINE 27

My Commission Expires: November 5, 1958

Wichita, Kansas
 CONSERVATION DIVISION
 MAY 11 1958
 RECEIVED
 STATE GEOLOGICAL SURVEY

James L. Jones
 Subscribed and sworn to before me this
 11th day of December 1954.

James L. Jones
 Notary Public

GRAHAM-MESSER-KIMMERT OIL COMPANY

The undersigned, GRAHAM-MESSER-KIMMERT OIL COMPANY, hereby certifies that the above log is a true and correct log of the formation encountered in drilling the above well as reflected by the Daily Drilling Report.

330	Shale-sand	330	336 (-1379)	Heebner
355	Clay-sand	355	3436 (-1479)	Brown Linn
472	Dakota sand	472	3478 (-1491)	Imaging
931	Shale	931	3726 (-1829)	Stampson
955	Argillite	955	3802 (-1845)	Atouchka
1146	Shale	1146		
1943	Shale-lime	1943		
2183	Shale-lime	2183		
2283	Shale-lime	2283		
3080	Shale-lime	3080		
3321	Shale-lime	3321		
3769	Shale-lime	3769		
3783	Shale-lime	3783		
3802	Shale-lime	3802		
3860	Atouchka	3860		

..... L O G

Casing Records: 8 5/8" @ 946' w/100 sacks cement
 5 1/2" @ 3860' w/75 sacks cement

Location: C W/2 SW SE, 8-21S-15W
 Pawnee County, Kansas
 Operator: Graham-Messner-Kimmert Drilling Co.
 1005 East Second, Wichita, Kansas
 Contractor: Graham-Messner-Kimmert Oil Company
 1005 East Second, Wichita, Kansas
 Production:
 Elevation: 1957 M
 Completed: December 4, 1954
 Commenced: November 23, 1954

WELL RECORD

NO. 1 SHEET REV.