


WELL PLUGGING RECORD

Give All Information Completely  
Make Required Affidavit  
Mail or Deliver Report to:  
Conservation Division  
State Corporation Commission  
212 North Market, Insurance Bldg.  
Wichita, Kansas

NORTH

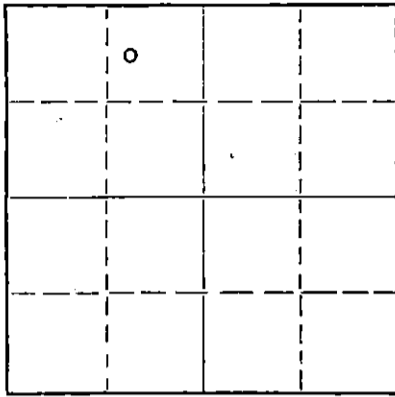

Locate well correctly on above  
Section Plat

Pawnee County, Sec. 8 Twp. 21 S Rge. (E) 15 (W)  
Location as "NE/CNW/SW" or footage from lines C. W/2 NE/4 NW/4  
Lease Owner Messman-Rinehart Oil Company  
Lease Name Sweeny "D" Well No. 1  
Office Address 518 Petroleum Building, Wichita, Kansas  
Character of Well (completed as Oil, Gas or Dry Hole) Gas  
Date well completed June 13 1954  
Application for plugging filed April 11 1960  
Application for plugging approved April 12 1960  
Plugging commenced April 11 1960  
Plugging completed April 14 1960  
Reason for abandonment of well or producing formation Depleted reservoir

If a producing well is abandoned, date of last production 19  
Was permission obtained from the Conservation Division or its agents before plugging was commenced? yes

Name of Conservation Agent who supervised plugging of this well Frank Broadfoot, 405 E. 6th St., St. John, Ks.  
Producing formation Depth to top Bottom Total Depth of Well 3805 Feet  
Show depth and thickness of all water, oil and gas formations.

OIL, GAS OR WATER RECORDS

CASING RECORD

FORMATION	CONTENT	FROM	TO	SIZE	PUT IN	PULLED OUT
				8-5/8"	958'	none
				5-1/2"	3805'	2600'

Describe in detail the manner in which the well was plugged, indicating where the mud fluid was placed and the method or methods used in introducing it into the hole. If cement or other plugs were used, state the character of same and depth placed, from feet to feet for each plug set.

Sand to 3730 ft. and dumped 5 sx. cement  
with dump bailer. Mud to 350 ft. and set  
rock bridge at 350 ft. with 20 sx. cement.  
Mud to 40 ft. and set 10 ft. rock bridge  
with 10 sx. cement to base of cellar.

RECEIVED  
IN COMMISSION

MAY 13 1960 5-13-60

CONSERVATION DIVISION  
Wichita, Kansas

(If additional description is necessary, use BACK of this sheet)

Name of Plugging Contractor Southwest Casing Pulling Co., Inc. - License No. 12  
Address Box 364, Great Bend, Kansas

STATE OF Kansas, COUNTY OF Sedgwick, ss.  
J. A. Gilliland (employee of owner) of the above-described  
well, being first duly sworn on oath, says: That I have knowledge of the facts, statements, and matters herein contained and the log of the  
above-described well as filed and that the same are true and correct. So help me God.

(Signature) *J. A. Gilliland*  
518 Petroleum Building, Wichita, Kansas  
(Address)

SUBSCRIBED AND SWORN TO before me this 21st day of April, 1960

My commission expires December 1, 1960

*Barbara J. Scott*  
Barbara J. Scott  
Notary Public.



DRILLERS LOG

Sweeney # 1  
 Sec: 8-21S-15W  
 Loc: C W/2 NE/4 NW/4  
 Pawnee County, Kansas

Comm: 6-1-54  
 Comp: 6-13-54  
 T. D. 3805'

Casing: 8 5/8" 958'  
 5 1/2" 3805'

Operator: Brooks Pierce Drilling Company  
 Contractor: Honaker Drilling Company

0	20	Top soil and clay
20	200	Sand and gravel
200	245	Blue shale
245	390	Shale
390	475	Sand
475	575	Red Bed
575	941	Red bed and shale
941	970	Anhydrite
970	1550	Shale and shells
1550	1640	Salt and shale
1640	1780	Lime and shale
1780	1835	Shale and lime
1835	1885	Lime
1885	3000	Lime and shale
3000	3085	Shale and lime
3085	3261	Lime and shale
3261	3380	Lime
3380	3457	Lime and shale
3457	3647	Lime
3647	3708	Lime and shale
3708	3805	Lime
3805		Total Rotary Depth

RECORDED  
 STATE CORPORATION COMMISSION

MAY 13 1960

CONSERVATION DIVISION  
 Wichita, Kansas

8 5/8" casing cemented @ 958' with  
 450 sacks cement and 9 sacks  
 calcium chloride

5 1/2" casing, cemented @ 3805' with  
 125 sacks cement

I certify that this is the true and correct copy of  
 the above log, to the best of my knowledge.

Subscribed and sworn to before me this 21st day of June 1954.

*Walter J. Fisher*  
 Notary Public

My Commission Expires 6-25-55