


STATE OF KANSAS  
STATE CORPORATION COMMISSION

WELL PLUGGING RECORD

Give All Information Completely  
Make Required Affidavit  
Mail or Deliver Report to  
Conservation Division  
State Corporation Comm.  
245 North Water  
Wichita, KS 67202

Pawnee County. Sec. 7 Twp. 21S Rge. 15 ~~NE~~/W  
Location as "NE/CNW/SW 1/4" or footage from lines  
C N/2 SW NE

Lease Owner Parkford Petroleum Co.  
Lease Name Kirby Well No. 1  
Office Address 2415 Campus, Suite 205, Irvine, Ca. 92715  
Character of Well (Completed as Oil, Gas or Dry Hole) dry hole

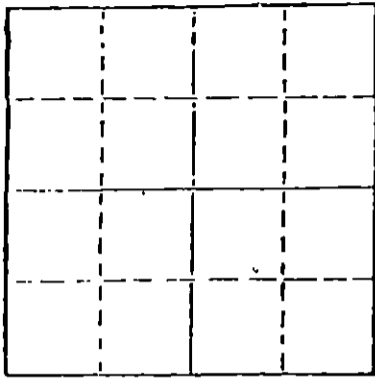

Locate well correctly on above  
Section Plat

Date Well completed 9-2 1978  
Application for plugging filed 9-2 1978  
Application for plugging approved 9-2 1978  
Plugging commenced 9-2 1978  
Plugging completed 9-2 1978

Reason for abandonment of well or producing formation  
no commercial quantities of oil or gas encountered

If a producing well is abandoned, date of last production  
-- 19

Was permission obtained from the Conservation Division or  
its agents before plugging was commenced? yes

Name of Conservation Agent who supervised plugging of this well Leo Massey  
Producing formation \_\_\_\_\_ Depth to top \_\_\_\_\_ Bottom \_\_\_\_\_ Total Depth of Well 3950  
Show depth and thickness of all water, oil and gas formations.

OIL, GAS OR WATER RECORDS

CASING RECORD

| FORMATION    | CONTENT | FROM | TO   | SIZE   | PUT IN | PULLED OUT |
|--------------|---------|------|------|--------|--------|------------|
| surface hole | shale   | surf | 972' | 8-5/8" | 964'   | none       |
|              |         |      |      |        |        |            |
|              |         |      |      |        |        |            |

Describe in detail the manner in which the well was plugged, indicating where the mud fluid  
was placed and the method or methods used in introducing it into the hold. If cement or other  
plugs were used, state the character of same and depth placed, from \_\_\_\_\_ feet to  
\_\_\_\_\_ feet for each plug set.

Fluid to 420', plug, 40 sx  
Fluid to 40', plug, 10 sx

RECEIVED  
STATE CORPORATION COMMISSION  
SEP 07 1978  
CONSERVATION DIVISION  
Wichita, Kansas  
9-7-78

(If additional description is necessary, use BACK of this sheet)

Name of Plugging Contractor DNB DRILLING, INC.  
515 R. H. Garvey Building  
Wichita, Kansas 67202

STATE OF Kansas COUNTY OF Sedgwick, ss.  
Ella Priess (employee of owner) or (owner or operator)

of the above-described well, being first duly sworn on oath, says: That I have knowledge of  
the facts, statements, and matters herein contained and the log of the above-described well  
as filed and that the same are true and correct. So help me God.

(Signature) Ella Priess  
Suite 515, R.H. Garvey Bldg., Wichita, Ks. 67202  
(Address)

SUBSCRIBED AND SWORN TO before me this 5th day of September, 1978

My commission expires 4/30/79

Dorothy L. Schmidt  
Notary Public.

DOROTHY L. SCHMIDT  
STATE NOTARY PUBLIC  
Sedgwick County, Kansas  
My Not. Exp. April 30, 1979

DRILLER'S-LOG

PARKFORD PETROLEUM CO.  
 No. 1 Kirby  
 C N/2 SW NE Sec. 7-21S-15W  
 Pawnee Co., Ks.

Commenced: 8-23-78  
 Completed: 9-3-78

Surface Casing: 964' of 8-5/8" 24#  
 new cemented w/475 sx 50-50 pozmix,  
 3% cc, 8-23-78

FORMATIONDEPTH

|              |             |
|--------------|-------------|
| Surface Hole | 0 - 972     |
| Anhydrite    | 972 - 980   |
| Shale        | 980 - 1800  |
| Shale & Lime | 1800 - 2286 |
| Lime & Shale | 2286 - 2500 |
| Shale & Lime | 2500 - 2720 |
| Lime & Shale | 2720 - 3545 |
| Lime         | 3545 - 3950 |

I do hereby certify that the foregoing statements are true and correct to the best of my knowledge and belief.

D N B DRILLING, INC.

*Ella Priess*  
 Ella Priess

STATE OF KANSAS: ss:

Subscribed and sworn to before me this 5th day of September, 1978.

*Dorothy L. Schmidt*  
 Dorothy L. Schmidt

DOROTHY L. SCHMIDT  
 STATE NOTARY PUBLIC  
 Sedgwick County, Kansas  
 My Appt. Exp. April 30, 1979