

STATE OF KANSAS
STATE CORPORATION COMMISSION


WELL PLUGGING RECORD

OR
FORMATION PLUGGING RECORD

Strike out upper line
when reporting plugging
off formations.

Give All Information Completely
Make Required Affidavit
Mail or Deliver Report to:
Conservation Division
State Corporation Commission
800 Pitting Building
Wichita, Kansas

NORTH

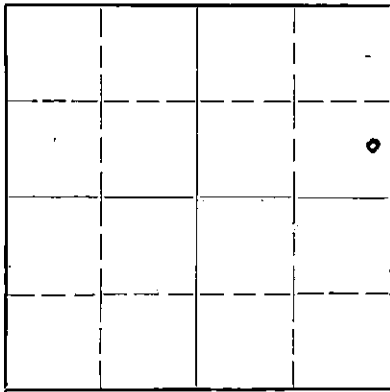

Locate well correctly on above
Section Plat

Stafford County. Sec. 3 Twp. 22 Rge. 13 (E) (W)
Location as "NE $\frac{1}{4}$ NW $\frac{1}{4}$ SW $\frac{1}{4}$ " or footage from lines E/2 SE/4 NE/4
Lease Owner Bartlett & Crum
Lease Name Kisner Well No. 1
Office Address Petroleum Bldg., Wichita, Ks.
Character of Well (completed as Oil, Gas or Dry Hole) Dry hole
Date well completed 9/19 19 43
Application for plugging filed 9/19 19 43
Application for plugging approved 9/19 19 43
Plugging commenced 9/19 19 43
Plugging completed 9/19 19 43
Reason for abandonment of well or producing formation Dry hole

If a producing well is abandoned, date of last production 19
Was permission obtained from the Conservation Division or its agents before plugging was commenced? Yes

Name of Conservation Agent who supervised plugging of this well C. T. Alexander
Producing formation Depth to top Bottom Total Depth of Well 3752 Feet
Show depth and thickness of all water, oil and gas formations.


OIL, GAS OR WATER RECORDS

CASING RECORD

Formation	Content	From	To	Size	Put In	Pulled Out

Describe in detail the manner in which the well was plugged, indicating where the mud fluid was placed and the method or methods used in introducing it into the hold. If cement or other plugs were used, state the character of same and depth placed, from feet to feet for each plug set.

Filled hole with heavy mud to 278'-wood plug & bridge-cement to 233'-
15 sacks-filled with heavy mud to 26'-bridge & 5 sacks cement.

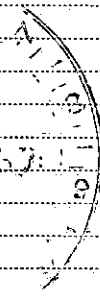

10-1-43

3 22 130
91 30

(If additional description is necessary, use BACK of this sheet)

Correspondence regarding this well should be addressed to B & R Drilling Co.
Address Box 487, Russell, Ks.

STATE OF Kansas COUNTY OF Russell, ss.

C. L. Roberts (employee of owner) or (owner or operator) of the above-described well,
being first duly sworn on oath, says: That I have knowledge of the facts, statements, and matters herein contained and the log of the above-described well as filed and that the same are true and correct. So help me God.

(Signature) C. L. Roberts

(Address)

SUBSCRIBED AND SWORN to before me this 29th day of September, 1943

Margaret Butcliffe
Notary Public

My commission expires April 16, 1947



Bartlett & Crum
Kinmer #1

Sec. 3 Twp. 12 Rgs. 13
Stafford Co., Kansas

Total Depth: 3752
Cons: 8/12/43 Comp: 9/15/43

Casing
14 Jts B 3/8" Set at 28'

Content
120 Sacks

Formation:	Depth:	Formation:	Depth:
Shale Sand	40'	Broken Lime Shale	2650
Sand	70	Shale Lime	2910
Sand Gravel	130	Lime	3260
Hard Sand	230	Shale Lime	3345
Red Rock Shale	284	Shale	3345
Red Rock	645	Lime	3480
Red Rock Shale	720	Salt Lime	3480
Anhydrite	750	Lime	3590
Shale Shells	1220	Conglomerate	3615
Salt	1335	Top Viola Lime	3627
Salt Shale 5	1400	Lime Chert	3655
Anhydrite Shale	1750	Simpson Sand Shale	3698
Shale Lime	1770	Arbuckle Lime	3752
Sandy Lime Shale	1900		
Sandy Lime	1760		
Sandy Lime Shale	1900		
Sandy Lime	2045		
Sandy Lime	2080		
Shale Lime	2505		

State of Kansas)
) SS
Russell County)



I hereby certify that the above information is true and correct to the best of my knowledge.

Ch Roberts

Subscribed and sworn to before me this 27th day of September, 1943.

Margaret Sutcliffe
Notary Public
My commission expires April 16, 1947

3 22 130
91 30