


STATE OF KANSAS
STATE CORPORATION COMMISSION

Give All Information Completely
Make Required Affidavit
Mail or Deliver Report to:
Conservation Division
State Corporation Commission
212 No. Market
Wichita, Kansas

Form CP-4
15-009-20218-0000
WELL PLUGGING RECORD

BARTON County, Sec. 7 Twp. 16S Rge. 12 (E) (W)
Location as "NE/CNWKSW" or footage from lines. NW NW NE
Lease Owner. PETROLEUM, INC.,
Lease Name. WEBER 'N' Well No. 1
Office Address. R.R. #2, GREAT BEND, KANSAS
Character of Well (completed as Oil, Gas or Dry Hole) DRY HOLE
Date well completed. MAY 5 19 68
Application for plugging filed. MAY 5 19 68
Application for plugging approved. MAY 5 19 68
Plugging commenced. MAY 5 19 68
Plugging completed. MAY 5 19 68
Reason for abandonment of well or producing formation. NO PRODUCIBLE ZONE

NORTH

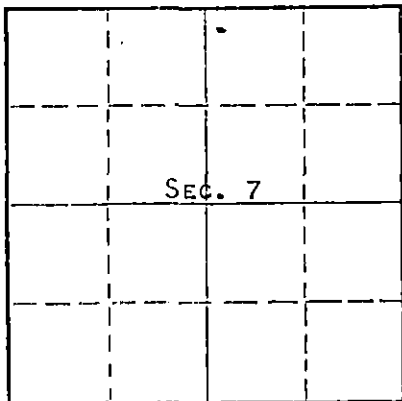

Locate well correctly on above Section Plat

If a producing well is abandoned, date of last production. NONE 19
Was permission obtained from the Conservation Division or its agents before plugging was commenced? YES

Name of Conservation Agent who supervised plugging of this well. DONALD TRUAN
Producing formation. Depth to top. Bottom. Total Depth of Well 3349' Feet
Show depth and thickness of all water, oil and gas formations.

OIL, GAS OR WATER RECORDS

CASING RECORD

FORMATION	CONTENT	FROM	TO	SIZE	PUT IN	PULLED OUT
				8-5/8"	369'	NONE

Describe in detail the manner in which the well was plugged, indicating where the mud fluid was placed and the method or methods used in introducing it into the hole. If cement or other plugs were used, state the character of same and depth placed, from feet to feet for each plug set.

MUD TO 500', WOODEN PLUG, 75 SACKS CEMENT. MUD TO 350', 25 SACKS CEMENT. MUD TO 40', BRIDGE TO HOLD KELLY BUSHING, 10 SACKS CEMENT TO BASE OF WELL CELLAR.

5-15-68

RECEIVED
STATE CORPORATION COMMISSION
MAY 15 1968
CONSERVATION DIVISION
Wichita, Kansas

(If additional description is necessary, use BACK of this sheet)
Name of Plugging Contractor. GARVEY DRILLING COMPANY
Address. R.R. #2, GREAT BEND, KANSAS

STATE OF KANSAS, COUNTY OF BARTON, ss.
MONTE CHADD (employee of owner) or (owner or operator) of the above-described well, being first duly sworn on oath, says: That I have knowledge of the facts, statements, and matters herein contained and the log of the above-described well as filed and that the same are true and correct. So help me God. MONTE CHADD, DIST. PROD. SUPT.
(Signature) *Monte Chadd*
R.R. #2, GREAT BEND, KANSAS
(Address)

SUBSCRIBED AND SWORN TO before me this 14 day of MAY, 19 68

Richard W. Dumbler
Notary Public.

My commission expires MAY 28, 1969

WELL LOG

COMPANY Petroleum, Inc.

SEC. 7 T. 16S R. 12W

FARM Weber 'N'

NO. 1

LOC. NW NW NE

TOTAL DEPTH 3349'


COUNTY Barton

COMM. 4-29-68

COMP. 5-5-68

CONTRACTOR Garvey Drilling Company

CASING 8 5/8" @ 369' w/200 sx

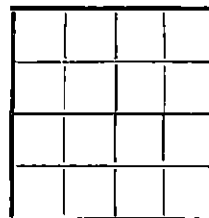

ELEVATION 1868' KB

PRODUCTION D & A

FIGURES INDICATE BOTTOM OF FORMATIONS

45' Hard Post Rock
85' Soils and Shells
236' Black Shale with Rock Streaks
369' Blue Shale with Sand Streaks
515' Shale
817' Red Bed
840' Anhydrite
1330' Shale and Shells
1730' Shale
2120' Lime and Shale
2660' Shale and Lime
2865' Lime and Shale
3349' Lime
3349' RTD

RECEIVED
STATE CORPORATION COMMISSION
MAY 15 1968
CONSERVATION DIVISION
Wichita, Kansas

State of Kansas }
County of Barton } ss

I, Sam N. Stephens of Garvey Drilling Company

upon oath state the above and foregoing is a true and correct copy of the log of the Weber 'N' No. 1 well.

Sam N. Stephens

Subscribed and sworn to before me this 10th day of May 1968

My Commission Expires: November 5th, 1969

Richard St. Boy
NOTARY PUBLIC