


STATE OF KANSAS
STATE CORPORATION COMMISSION

Give All Information Completely
Make Required Affidavit
Mail or Deliver Report to:
Conservation Division
State Corporation Commission
211 No. Broadway
Wichita, Kansas

15-009-06718-0050
WELL PLUGGING RECORD

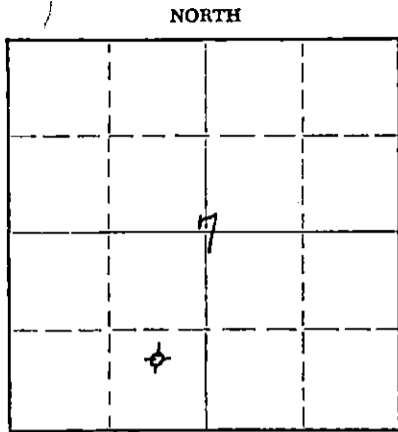

Locate well correctly on above Section Plat

Barton County. Sec. 7 Twp. 16 Rge. (E) 12 (W)
Location as "NE/CNW/SW" or footage from lines N/2 SE/4 SW/4
Lease Owner Thos. H. Allan
Lease Name Stiles Well No. 3
Office Address 925 Union Center, Wichita 2, Kansas
Character of Well (completed as Oil, Gas or Dry Hole) Dry Hole
Date well completed May 29 1959
Application for plugging filed May 29 1959
Application for plugging approved May 29 1959
Plugging commenced June 1 1959
Plugging completed June 1 1959
Reason for abandonment of well or producing formation Dry Hole

If a producing well is abandoned, date of last production 19
Was permission obtained from the Conservation Division or its agents before plugging was commenced? Yes

Name of Conservation Agent who supervised plugging of this well Don Truan
Producing formation Arbuckle Depth to top 3358 Bottom ----- Total Depth of Well 3378 Feet
Show depth and thickness of all water, oil and gas formations. Black Water 3376-3378

OIL, GAS OR WATER RECORDS

Perforated 30 holes 3018-3022 - only trace of O & G

CASING RECORD

FORMATION	CONTENT	FROM	TO	SIZE	PUL IN	PULLED OUT
				8 5/8"	408'	None
				5 1/2"	3363'	2552'

Describe in detail the manner in which the well was plugged, indicating where the mud fluid was placed and the method or methods used in introducing it into the hole. If cement or other plugs were used, state the character of same and depth placed, from feet to feet for each plug set.

3378 - 3056 Mud, Halliburton Plug, Rock, Galseal and Rubber Plug
3056 - 3010 Sand
3010 - 2960 5 sacks of cement
 2552 5 1/2" Casing Pulled
2960 - 350 Mud
350 - 280 Bridge of 1/3 sack of Halls, Rock & 25 sacks of cement
280 - 40 Mud
40 - Surface Bridge of 1/3 sack of Halls, Rock, & 10 sacks of cement

RECEIVED
STATE CORPORATION COMMISSION

JUN 11 1959

CONSERVATION DIVISION
Wichita, Kansas

rcw
06-11-59

(If additional description is necessary, use BACK of this sheet)
Name of Plugging Contractor Thos. H. Allan
Address 925 Union Center, Wichita 2, Kansas

STATE OF KANSAS, COUNTY OF SEDGWICK, ss.
Thos. H. Allan (employee of owner) or (owner or operator) of the above-described well, being first duly sworn on oath, says: That I have knowledge of the facts, statements, and matters herein contained and the log of the above-described well as filed and that the same are true and correct. So help me God.

(Signature) Thos H, Allan
925 Union Center, Wichita 2, Kansas
(Address)

SUBSCRIBED AND SWORN TO before me this 10th day of June, 1959

Quie M. Stewart

My commission expires June 14, 1962

Notary Public.

PLUGGING
FILE SEC. 7 T. 16 R. 124
BOOK PAGE 44 LINE 27

8 5/8" @ 408' - 200 Sx
5 1/2" @ 3363' - 125 Sx - 2552' Pulled

ALLAN, et al - #3 STILES
CN/2 SE SW 7-16-12W
Barton County, Kansas
COMM: 5/14/59 COMPL: 6/1/59
CONTRACTOR: Tom Allan
ELEVATION: 1882 RB
I.P. D & A

All Depths From Rotary Bushings

0 - 20 Soil
55 Lime
120 Sandy Black Shale
200 Clay and Shale
240 Sand and Shells
265 Clay and Red Shale
300 Gray Limey Shale
375 Sandy Shale
500 Blue Gumbo
832 Red Beds
860 Anhydrite
1000 Red Beds
1050 Shale
1100 Red Shale
1200 Shale
1450 Shale and Salt
1500 Shale
1600 Anhydrite and Shale
1700 Shale & Shells
1800 Lime
2000 Shale and Shells
2050 Red Shale
2200 Lime
2700 Shale and Shells
2840 Lime
2870 Lime and Shale
2940 Lime
2943 Collicastic Porous Lime W/VSSO
2996 Lime
2999 Black Shale
3002 Lime
3015 Shale
3019 Lime
3023 Slightly Porous Lime W/SSO
3026 Lime
3040 Shale
3058 Fine Gray Sand
3083 Sandy Shale
3089 Brown Dense Lime
3095 Shale
3100 Lime
3103 Porous Collicastic Lime
3127 Lime
3132 Collicastic Porous Lime
3162 Lime and Shale
3178 Very Cherty Lime
3195 Collicastic Porous Lime
3216 Lime
3245 Lime and Shale
3260 Lime
3267 Partly Porous Lime W/SSO

3272 Porous Collicastic Lime
3282 Lime
3301 Shale
3345 Lime
3355 Shale
3358 V. C. Chert & Red Sandy Mud
3363 (RTD) White to Buff Medium
Crystalline Dolomite
CHANGED TO CABLE TOOLS
3367 Cherty Dolomite, Little Mud
3374 Weathered Crystalline Dolomite & Mud
3376 Vitreous Chert
3378 (TD) Crystalline Dolomite & Water
Test 5 bbl. Hr. of Black Water
Top of Plug @ 3056
Perforated 30 holes 3018-3022 & 506 gal. acid
Test, Trace of Oil & Gas with Acid Water

TOPS:

832	Anhydrite
2996	Huebner
3083	Brown Lime
3095	Lansing
3355	Conglomerate
3358	Arbuckle

I certify that this is a true and correct copy of the well log.

Tom Allan

Subscribed and sworn to before me this 3rd day of June, 1959.

Osie M. Stewart
Notary Public

My commission expires June 14, 1962.

PLUGGING	
FILE SEC.	7 T. 16 R. 12W
BOOK PAGE	44 LINE 27