

STATE OF KANSAS
STATE CORPORATION COMMISSION

WELL PLUGGING RECORD

15-009-22222-8000

Give All Information Completely
Make Required Affidavit
Mail or Deliver Report to
Conservation Division
State Corporation Comm.
245 North Water
Wichita, KS 67202

Barton County, Sec. 7 Twp. 16S Rge. 12 NE/W
Location as "NE/CNW 1/4 SW 1/4" or footage from lines

NW NW SW SE AUB KCC
Lease Owner Petro-Midwest Corporation
Lease Name Warta Well No. 1

Office Address 210 E. 6th
Character of Well (Completed as Oil, Gas or Dry Hole)

Dry Hole

Date Well completed 4-18 1981

Application for plugging filed 4-18 1981

Application for plugging approved 4-18 1981

Plugging commenced 4-18 1981

Plugging completed 4-18 1981

Reason for abandonment of well or producing formation

Dry Hole


If a producing well is abandoned, date of last production 19

Was permission obtained from the Conservation Division or its agents before plugging was commenced? Yes

Name of Conservation Agent who supervised plugging of this well Duane L. Rankin

Producing formation _____ Depth to top _____ Bottom _____ Total Depth of Well _____

Show depth and thickness of all water, oil and gas formations.

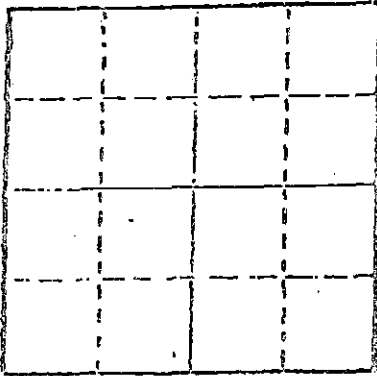

Locate well correctly on above Section Plot

OIL, GAS OR WATER RECORDS

CASING RECORD

FORMATION	CONTENT	FROM	TO	SIZE	PUT IN	PULLED OUT
				8-5/8"	618'	-0-

Describe in detail the manner in which the well was plugged, indicating where the mud fluid was placed and the method or methods used in introducing it into the hold. If cement or other plugs were used, state the character of same and depth placed, from _____ feet to _____ feet for each plug set.

Mud laden fluid 3401' - 600'
25 sacks cement @ 600'
25 sacks cement @ 300'
10 sks cement @ 40' w/bridge
5 sks cement in rat hole.

(If additional description is necessary, use BACK of this sheet)

Name of Plugging Contractor Emphasis Oil Operations

STATE OF KANSAS COUNTY OF RUSSELL, ss.
Joe K. Branum (employee of owner) or (owner or operator)
of the above-described well, being first duly sworn on oath, says: That I have knowledge of the facts, statements, and matters herein contained and the log of the above-described well as filed and that the same are true and correct. So help me God.

(Signature)

Joe K. Branum
Post Office Box 506, Russell, KS 67665
(Address)

SUBSCRIBED AND SWORN TO before me this 20th day of April, 19 81.

My commission expires February 6, 1984.

RECEIVED
STATE CORPORATION COMMISSION
Glenda R. Tiffin
Notary Public.
APR 21 1981
04-21-81
My Appt. Exp. 2-6-84



EMPHASIS OIL OPERATIONS

P. O. Box 506

Russell, Kansas 67665

DRILLERS LOG

OPERATOR: Petro-Midwest Corporation
210 E. 6th Street
South Hutchinson, Kansas 67505

CONTRACTOR: Emphasis Oil Operations
P. O. Box 506
Russell, Kansas 67665

LEASE: Warta WELL: #1

LOCATION: NW NW SW
Section 7-16S-12W
Barton County, Kansas

Total Depth: 3401'

Elevation:

Commenced: 4-13-81

Completed: 4-18-81

Casing: 8-5/8" @ 618' with 300 sks cement

Status: Dry Hole

DEPTHS & FORMATIONS

(All measurements from K.B.)

Top Soil & Sand	30'	Shale & Lime	2361'
Shale	280'	Shale	2715'
Shale & Sand	933'	Lime & Shale (R.T.D.)	3401'
Shale	1835'		

RECEIVED
STATE CORPORATION COMMISSION

APR 21 1981

CONSERVATION DIVISION

STATE OF KANSAS)
) ss:
COUNTY OF RUSSELL)

I, Joe K. Branum, of Emphasis Oil Operations, state that the above and foregoing is a true and correct log of the above captioned well.

Joe K. Branum

Joe K. Branum

Subscribed and sworn to before me this 20th day of April, 1981.

My Commission Expires: February 6, 1984.



Glenda R. Tiffin

Notary Public