

*Rec'd
9-1-84*


STATE OF KANSAS
STATE CORPORATION COMMISSION

WELL PLUGGING RECORD

Give All Information Completely
Make Required Affidavit
Mail or Deliver Report to
Conservation Division
State Corporation Comm.
245 North Water
Wichita, KS 67202

Pawnee County, Sec. 25 Twp. 21S Rge. 20 W/W
Location as "NE/CNW 1/4 SW 1/4" or footage from lines
C SE 1/4

Lease Owner Benson Mineral Group, Inc.
Lease Name Tindall-Akers A Well No. 1-25
Office Address 1536 Cole Blvd., #220, Golden, CO 80401
Character of Well (Completed as Oil, Gas or Dry Hole)
Dry Hole

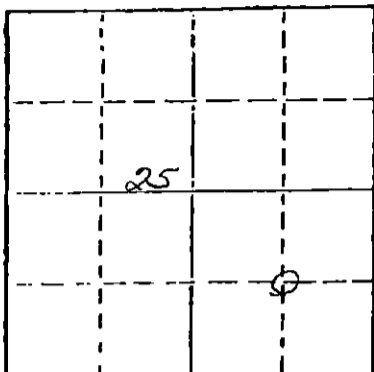

Locate well correctly on above
Section Plat

Date Well completed 12-13 19 80
Application for plugging filed 8-8 19 83
Application for plugging approved 8-15 19 83
Plugging commenced 8-19 19 83
Plugging completed 8-31 19 83

Reason for abandonment of well or producing formation
Dry Hole
If a producing well is abandoned, date of last production
NA 19

Was permission obtained from the Conservation Division or
its agents before plugging was commenced? yes

Name of Conservation Agent who supervised plugging of this well J. Metz
Producing formation NA Depth to top NA Bottom NA Total Depth of Well 2370
Show depth and thickness of all water, oil and gas formations.

OIL, GAS OR WATER RECORDS

CASING RECORD

FORMATION	CONTENT	FROM	TO	SIZE	PUT IN	PULLED OUT
Chase Group	water	2202	2304	7"	960	0
				4 1/2"	2367	752.02

Describe in detail the manner in which the well was plugged, indicating where the mud fluid
was placed and the method or methods used in introducing it into the hold. If cement or other
plugs were used, state the character of same and depth placed, from feet to
feet for each plug set.

Pump 3 sx hulls, 125 sx 60-40 POZ from 2202 to 1700', back off 4 1/2" recover 752.02'
of 4 1/2". Pump 25 sx 60-40 POZ to 750', 9.5# mud to 960'. Pump 100 sx 60-40 POZ,
3 sx hulls to surface. Cut off 7" 3' below ground level.

(If additional description is necessary, use BACK of this sheet)

Name of Plugging Contractor Sun Oilwell Cementing

STATE OF COLORADO COUNTY OF JEFFERSON, ss.
James S. Jameson (employee of owner) or (owner or operator)
of the above-described well, being first duly sworn on oath, says: That I have knowledge of
the facts, statements, and matters herein contained and the log of the above-described well
as filed and that the same are true and correct. So help me God.

(Signature) *[Signature]*
1536 Cole Blvd., Suite 220, Golden, CO 80401
(Address)

SUBSCRIBED AND SWORN TO before me this 19th day of October, 19 83

My commission expires July 25, 1986
[Signature] Marilyn M. Markel Notary Public.

TINDALL-AKERS A #1-25
PLUGGING PROCEDURE
August 8, 1983

7" @ 960 x 250 sx 60-40 POZ, 3% CC, 3% gel
4½" @ 2367' x 125 sx lite cmt, 6% gel, 100 sx 50-50 POZ, 10% NaCl
Top cmt from bond log 1626'
Perfs 2202-72'

1. Pump down annulus between 7" x 4½" to determine rate.
2. Pump 1 sx x hulls & 150 sx common, 5% gel to 2200' down 4½".
3. Squeeze down 7" x 4½" annulus x 75 sx common, 5% gel, 1 sx hulls.