

STATE OF KANSAS  
STATE CORPORATION COMMISSION


Form CP-4

Give All Information Completely  
Make Required Affidavit  
Mail or Deliver Report to:  
Conservation Division  
State Corporation Commission  
212 No. Market  
Wichita, Kansas 67202

WELL PLUGGING RECORD

Pawnee County, Sec. 35 Twp. 21S Rge. 20 (X) W (W)

Location as "NE/CNWSW" or footage from lines SE $\frac{1}{4}$ , SE $\frac{1}{4}$ , NE $\frac{1}{4}$   
Lease Owner Antares Oil Corporation  
Lease Name Charles I. Hager Well No. 1  
Office Address 1660 Lincoln Street, #1530, Denver, Co. 80264  
Character of Well (completed as Oil, Gas or Dry Hole) Dry Hole  
Date well completed June 7, 1979 19  
Application for plugging filed 6/7/79 verbal to Wilmer Dreiling 19  
Application for plugging approved 6/7/79 from Marion Schmidt 19  
Plugging commenced June 7, 1979  
Plugging completed 2:00 PM June 7, 1979  
Reason for abandonment of well or producing formation Dry hole

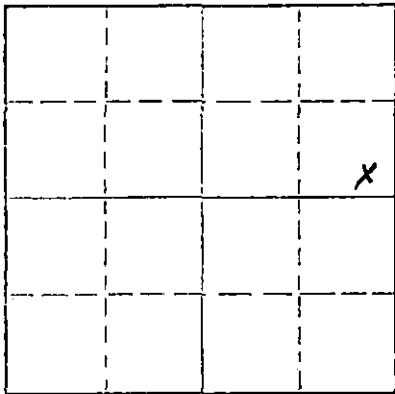

Locate well correctly on above Section Plot

If a producing well is abandoned, date of last production 19  
Was permission obtained from the Conservation Division or its agents before plugging was commenced? yes

Name of Conservation Agent who supervised plugging of this well Marion Schmidt  
Producing formation \_\_\_\_\_ Depth to top \_\_\_\_\_ Bottom \_\_\_\_\_ Total Depth of Well 4347 Feet  
Show depth and thickness of all water, oil and gas formations.

OIL, GAS OR WATER RECORDS

CASING RECORD

FORMATION	CONTENT	FROM	TO	SIZE	PUT IN	PULLED OUT
				8 5/8"	1228'	None

Describe in detail the manner in which the well was plugged, indicating where the mud fluid was placed and the method or methods used in introducing it into the hole. If cement or other plugs were used, state the character of same and depth placed, from \_\_\_\_\_ feet to \_\_\_\_\_ feet for each plug set.

Plug #1 at 750' with 60 sacks cement.  
Plug #2 at 350' with 30 sacks cement  
Plug #3 at 40'-0' with 10 sacks cement.  
Hole was conditioned with heavy drilling mud.

7-9-79

RECEIVED  
STATE CORPORATION COMMISSION

JUL 9 1979

CONSERVATION DIVISION  
Wichita, Kansas

(If additional description is necessary, use BACK of this sheet)

Name of Plugging Contractor Halliburton (HOWCO)  
Address 410 Union Center, Wichita, Kansas 67202

STATE OF COLORADO, COUNTY OF DENVER, ss.

HAL C. PORTER (owner or operator) of the above-described well, being first duly sworn on oath, says: That I have knowledge of the facts, statements, and matters herein contained and the log of the above-described well as filed and that the same are true and correct. So help me God.

(Signature)

1660 Lincoln, #1530, Denver, Co. 80264  
(Address)

SUBSCRIBED AND SWORN TO before me this 3rd day of July, 1979

Barbara A. Pensiero  
Notary Public.

GABBERT-JONES, INC.  
WICHITA, KANSAS  
DRILLERS' WELL LOG

Hager #1  
SE SE NE Sec 35-21S-20W  
Pawnee County Kansas

Commenced: 5-30-79

Completed: 6-7-79

OPERATOR: Antares Oil Co.

Depth		Formation	Remarks
From	to		
0	520	Shale-Sand	Ran 30 jts of 28# 8 5/8" csg set @ 1228' w/Notched Texas Pattern Shoe & 3 Centerlizers - Cemented w/ 550 sks of 50/50 Posmix 2% Gel - 3% CC PD @ 9:25 a.m. 5-31-79  DRY & ABANDONED
520	1090	Shale	
1090	1219	Redbed	
1219	1247	Anhy.	
1247	1848	Shale	
1848	2140	Shale-Shells	
2140	3070	Shale-Lime	
3070	3886	Lime-Shale	
3886	4347	Lime	
	4347 - TD		

STATE OF KANSAS )  
                          ) SS  
COUNTY OF SEDGWICK)

I, the undersigned, being duly sworn on oath, state that the above Drillers' Well Log is true and correct to the best of my knowledge and belief and according to the records of this office.

GABBERT-JONES, INC.

*James S. Sutton II*  
JAMES S. SUTTON II

Subscribed and sworn to before me this 14th day of June, 1979.

*Elizabeth J. Edwards*  
ELIZABETH J. EDWARDS-NOTARY PUBLIC

My Commission expires February 6, 1983.

RECEIVED  
STATE CORPORATION COMMISSION

JUL - 9 1979

CONSERVATION DIVISION  
Wichita, Kansas

