


WELL PLUGGING RECORD

Give All Information Completely
Make Required Affidavit
Mail or Deliver Report to:
Conservation Division
State Corporation Commission
211 No. Broadway
Wichita, Kansas

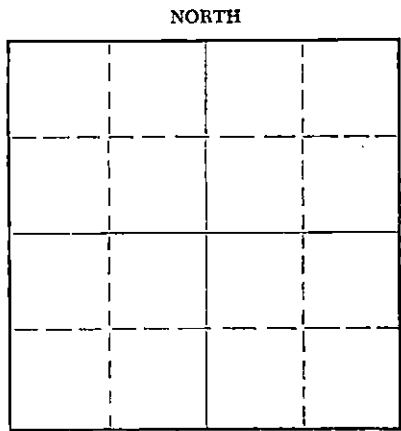

Locate well correctly on above Section Plat

Pawnee County. Sec. 35 Twp. 21 Rge. 20 (E) (W)
Location as "NE/CNW $\frac{1}{2}$ SW $\frac{1}{4}$ " or footage from lines John NE/NE/NE
Lease Owner Jones, Shelburne & Farmer, Inc.
Lease Name Merrett Well No. #1
Office Address Russell, Kansas
Character of Well (completed as Oil, Gas or Dry Hole) _____
Date well completed _____ 19____
Application for plugging filed Yes 19____
Application for plugging approved Yes 19____
Plugging commenced 10-6 19 57
Plugging completed 10-23 19 57
Reason for abandonment of well or producing formation _____

If a producing well is abandoned, date of last production _____ 19____
Was permission obtained from the Conservation Division or its agents before plugging was commenced? Yes

Name of Conservation Agent who supervised plugging of this well Mr. R.M. Brundedge
Producing formation _____ Depth to top _____ Bottom _____ Total Depth of Well 4565' Feet
Show depth and thickness of all water, oil and gas formations.

OIL, GAS OR WATER RECORDS

CASING RECORD

FORMATION	CONTENT	FROM	TO	SIZE	PUT IN	PULLED OUT
				5 1/2"		2,314'

Describe in detail the manner in which the well was plugged, indicating where the mud fluid was placed and the method or methods used in introducing it into the hole. If cement or other plugs were used, state the character of same and depth placed, from _____ feet to _____ feet for each plug set.

Measured into T.D. 4565'.
Plugging started 10-6-57. Finished 10-23-57.
Shot and worked pipe. Mixed mud and hull. Spotted oil, and mixed and pumped in mud through 8 5/8". Worked and shot pipe. Mud bridge at 1400' and pumped out bridge. Circulated and spotted oil. Worked and shot pipe. Mixed and pumped 20 sacks mud and 85 sacks cement. Well completed.

RECEIVED
NOV 11-6-57
CONSERVATION DIVISION
Wichita, Kansas

(If additional description is necessary, use BACK of this sheet)
Name of Plugging Contractor J.O. Forbes d/b/a Forbes Casing Pulling Co.
Address Box 221, Great Bend, Kansas


STATE OF Kansas, COUNTY OF Barton, ss.
J.O. Forbes (employee of owner) or (owner or operator) of the above-described well, being first duly sworn on oath, says: That I have knowledge of the facts, statements, and matters herein contained and the log of the above-described well as filed and that the same are true and correct. So help me God.

(Signature) J.O. Forbes
Box 221, Great Bend, Kansas
(Address)

SUBSCRIBED AND SWORN TO before me this 4th day of November, 1957.

My commission expires November 8, 1960.
Betty S. Edman Notary Public.

PLUGGING
FILE SEC 35 T 21 R 20 W
BOOK PAGE 47 LINE 19

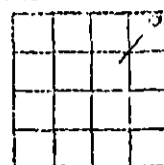WELL LOG BUREAU - KANSAS GEOLOGICAL SOCIETY
508 East Murdock, Wichita, KansasCompany- JONES, SHELburnE & FARMER, Inc.
Farm- Merritt No. 1SEC. 35 T. 21 R. 20W
NE NE NETotal Depth. 4565
Comm. 7-30-57 Comp. 8-21-57
Sect. or Treated.
Contractor: Jones, Shelburne & Farmer, Inc.
Issued. 11-2 -57County Pawnee
KANSAS

CASING:

8 5/8" 570' cem w/300 sx
5 1/2" 4270' cem w/75 sx

Elevation. 2102'

Production. Dry

Figures indicate Bottom of Formations.

Surface	30
Shale & shells	580
Shale, sand & red bed	725
Sand	800
Shale, shells & red bed	1100
Shale & redbed	1210
Anhydrite	1440
Shale & shells	1700
Shale & lime	2420
Lime, sandy	2490
Lime & shale	2860
Shale & lime	2960
Shale & shells	3095
Shale & lime	3250
Lime & shale	3595
Lime	3655
Lime & shale	3735
Lime	4020
Lime & shale	4060
Lime	4130
Lime & shale	4225
Lime	4235
Lime (cherty)	4277
Miss chert	4281
Sand	4380
Lime shale & chert	4410
Lime	4490
Lime shale & chert	4505
Lime	4523
Arbuckle lime	4565
Total Depth	

TOPS:

Anhydrite (scout)	1210
Topeka	3309
Heebner	3610
Toronto	3625
Lansing Kansas City	3666
Base Kansas City	4018
Cherokee group	4127
Cherokee sand	4208
Mississippi chat	4222
Kinderhook sand	4275
Kinderhook dolomite	4295
Misner sand	4366
Viola dolomite	4372
Simpson dolomite	4488
Simpson shale & sand	4510
Arbuckle dolomite	4522