


WELL PLUGGING RECORD

Give All Information Completely
Make Required Affidavit
Mail or Deliver Report to:
Conservation Division
State Corporation Commission
212 No. Market
Wichita, Kansas

NORTH

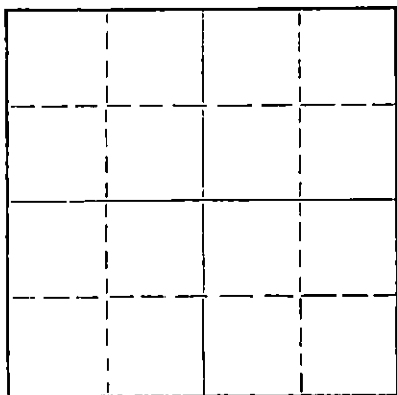

Locate well correctly on above
Section Plat

Pawnee County, Sec. 1 Twp. 21S Rge. 20W (EX XW)

Location as "NE/CNW/SW" or footage from lines C SW

Lease Owner Sterling Drilling Company

Lease Name Woods Well No. 1

Office Address P. O. Box 129, Sterling, KS 67579

Character of Well (completed as Oil, Gas or Dry Hole) Dry Hole

Date well completed July 1 1978

Application for plugging filed July 1 1978

Application for plugging approved July 1 1978

Plugging commenced July 1 1978

Plugging completed July 1 1978

Reason for abandonment of well or producing formation

dry hole

If a producing well is abandoned, date of last production 19

Was permission obtained from the Conservation Division or its agents before plugging was commenced? yes

Name of Conservation Agent who supervised plugging of this well Leo Massey, Hays, Kansas

Producing formation Depth to top Bottom Total Depth of Well 4325 Feet

Show depth and thickness of all water, oil and gas formations.

OIL, GAS OR WATER RECORDS

CASING RECORD

FORMATION	CONTENT	FROM	TO	SIZE	PUT IN	PULLED OUT

Describe in detail the manner in which the well was plugged, indicating where the mud fluid was placed and the method or methods used in introducing it into the hole. If cement or other plugs were used, state the character of same and depth placed, from feet to feet for each plug set.

Plugged hole as follows: Filled hole w/rotary mud - pumped 50 sx thru O.E. D.P. @ 420', mud to 240 - pumped 25 sx thru O.E.D.P. mud to 40', 1/2 sx hulls & wood plug for solid bridge - pumped 10 sx to base of cellar - 2 sx in rathole - used 50/50 pozmix w/2% gel, completed @ 12:45 a.m. 7-1-78 by Halliburton.

STATE OF KANSAS
JUL 06 1978
CONSERVATION DIVISION
Wichita, Kansas
7-6-78

(If additional description is necessary, use BACK of this sheet)

Name of Plugging Contractor Husky Drilling Co., Inc.

Address 800 Bitting Building, Wichita, KS 67202

STATE OF KANSAS, COUNTY OF Sedgwick, ss.

Jon T. Williams, Jr. (employee of owner) or (owner/representative) of the above-described


well, being first duly sworn on oath, says: That I have knowledge of the facts, statements, and matters herein contained and the log of the above-described well as filed and that the same are true and correct. So help me God.

(Signature) Jon T. Williams, Jr.
800 Bitting Bldg., Wichita, KS 67202
(Address)

SUBSCRIBED AND SWORN TO before me this 1st day of July, 19 78

Geraldine Stewart
Geraldine Stewart Notary Public.

My commission expires January 12, 1981

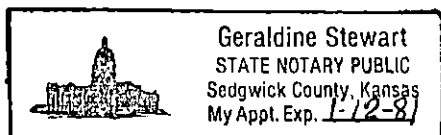



800 Bitting Bl'g
 Wichita, Kansas 67202
 Phone 316 - 263-7904
 Mobile Phone 316 - 793-7859 Unit 7070

July 3, 1978

WELL LOG Woods No. 1
 Located: C SW, Section 1-21S-20W, Pawnee County, KS

OWNER: Sterling Drilling Company
 ROTARY DRILLING CONTRACTOR: Husky Drilling Co., Inc.

COMMENCED: June 22, 1978
 COMPLETED: July 1, 1978

TOTAL DEPTH: 4325'

<u>LOG</u>		<u>CASING RECORD</u>
0	- 60	Soil sand
60	- 296	Sand, Shells & Shale
296	- 725	Shale
725	- 875	Sand
875	- 1297	Shale & Shells & Red Bed
1297	- 1320	Anhydrite
1320	- 1595	Shale & Shells
1595	- 3192	Shale & Lime
3192	- 3388	Shale
3388	- 3756	Shale & Lime
3756	- 3965	Lime
3965	- 4056	Lime & Shale
4056	- 4140	Lime
4140	- 4191	Lime-Chert
4191	- 4265	Lime & Shale
4265	- 4325	Chert

RECEIVED
 STATE CORPORATION COMMISSION
 JUL 06 1978
 CONSERVATION DIVISION
 Wichita, Kansas

Plugged