


WELL PLUGGING RECORD

Give All Information Completely  
Make Required Affidavit  
Mail or Deliver Report to:  
Conservation Division  
State Corporation Commission  
211 No. Broadway  
Wichita, Kansas

Hodgeman County, Sec. 15 Twp. 21 Rge. 21 (E) (W)

Location as "NE/CNWxSWx" or footage from lines NW/4 SW/4  
Lease Owner Beardmore Drilling Company  
Lease Name Huling Well No. 3  
Office Address 827 Beacon Building, Wichita, Kansas  
Character of Well (completed as Oil, Gas or Dry Hole) Dry Hole  
Date well completed 12-22 19 63  
Application for plugging filed 12-22 19 63  
Application for plugging approved 12-22 19 63  
Plugging commenced 12-22 19 63  
Plugging completed 12-22 19 63  
Reason for abandonment of well or producing formation Dry Hole

NORTH

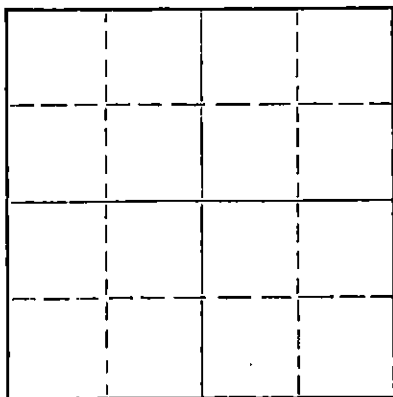

Locate well correctly on above  
Section Plat

If a producing well is abandoned, date of last production \_\_\_\_\_ 19\_\_\_\_  
Was permission obtained from the Conservation Division or its agents before plugging was commenced? \_\_\_\_\_

Name of Conservation Agent who supervised plugging of this well Hugh E. Scott  
Producing formation \_\_\_\_\_ Depth to top \_\_\_\_\_ Bottom \_\_\_\_\_ Total Depth of Well \_\_\_\_\_ Feet  
Show depth and thickness of all water, oil and gas formations.

OIL, GAS OR WATER RECORDS

CASING RECORD

FORMATION	CONTENT	FROM	TO	SIZE	PUT IN	PULLED OUT

Describe in detail the manner in which the well was plugged, indicating where the mud fluid was placed and the method or methods used in introducing it into the hole. If cement or other plugs were used, state the character of same and depth placed, from \_\_\_\_\_ feet to \_\_\_\_\_ feet for each plug set.

4362' - 700' - Heavy rotary mud  
700' - 700' - Halliburton plug, 35 sacks cement  
700' - 45' - Heavy Rotary Mud  
45' - 0' - Halliburton plug, 15 sacks cement

RECEIVED  
STATE CORPORATION COMMISSION

JAN 3 1964

CONSERVATION DIVISION  
Wichita, Kansas

(If additional description is necessary, use BACK of this sheet)  
Name of Plugging Contractor Peel Brothers, Inc.  
Address Box 359, Hoisington, Kansas

STATE OF Kansas, COUNTY OF Barton, ss.  
Peel Brothers, Inc. (\_\_\_\_\_ of owner) or (\_\_\_\_\_ of operator) of the above-described

well, being first duly sworn on oath, says: That I have knowledge of the facts, statements, and matters herein contained and the log of the above-described well as filed and that the same are true and correct. So help me God. PEEL BROTHERS, INC

(Signature) Wendell C. Peel  
Wendell C. Peel, President

Box 359, Hoisington, Kansas  
December \_\_\_\_\_, 19 63

SUBSCRIBED AND SWORN TO before me this 30th day of \_\_\_\_\_

My commission expires June 21, 1966

Esther S. Williamson  
Notary Public.

DRILLER'S LOG

Well Owner: Beardmore Drilling Company  
 Farm Name: Huling No. 3  
 Total Depth: 4362  
 Commenced: 12-10-63  
 Completed: 12-22-63  
 Contractor: Peel Brothers, Inc.  
 Casing: 8-5/8" @ 650' cem.

NW/4 SW/4 (Approx. NW SW)  
 Section 15-21-21  
 Hodgeman County, Kansas

Elevation:

Production: Dry

Figures below indicate bottoms of formations:

Surface Clay and Sand	0	- 125
Sand		250
Shale and Shells		619
Anhydrite		1307
Shale		1415
Shale, Chalk and Shells		3440
Shale, Chalk and Lime		3640
Lime		4320
Shale and Lime		4355
Lime and Shale		3868
Lime and Chert		4362
Total Depth		4362

**RECEIVED**  
 STATE CORPORATION COMMISSION

JAN 3 1964

CONSERVATION DIVISION  
 Wichita, Kansas

This is to certify that the above information is to the best of our knowledge true and correct.

PEEL BROTHERS, INC.

*Wendell G. Peel*  
 Wendell G. Peel  
 President

SUBSCRIBED AND SWORN to before me this 30th day of December, 1963.

My commission expires June 21, 1966

*Ethel S. Williamson*  
 Ethel S. Williamson  
 Notary Public