

STATE OF KANSAS
STATE CORPORATION COMMISSION


Give All Information Completely
Make Required Affidavit
Mail or Deliver Report to:
Conservation Division
State Corporation Commission
211 No. Broadway
Wichita, Kansas

WELL PLUGGING RECORD

Hodgeman County. Sec. 15 Twp. 21 Rge. 21 (E) W (W)
NE SW

Location as "NE/CNW%SW%" or footage from lines _____
Lease Owner Beardmore Drilling Co.
Lease Name Huling Well No. 4
Office Address 827 Beacon Bld'g Wichita, Kansas
Character of Well (completed as Oil, Gas or Dry Hole) Dry Hole
Date well completed 6-20 19 64
Application for plugging filed 6-20 19 64
Application for plugging approved 6--20 19 64
Plugging commenced 6-20 19 64
Plugging completed 6-20 19 64
Reason for abandonment of well or producing formation Dry Hole

NORTH

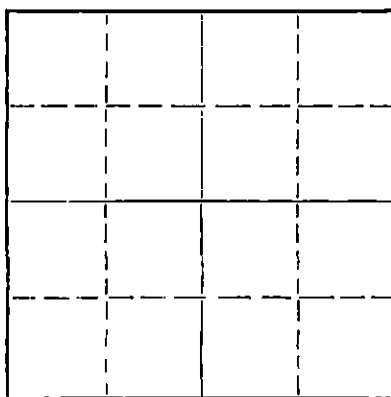

Locate well correctly on above
Section Plat

If a producing well is abandoned, date of last production _____ 19____
Was permission obtained from the Conservation Division or its agents before plugging was com-
menced? yes

Name of Conservation Agent who supervised plugging of this well Hugh Scott - Sublette, Kansas
Producing formation _____ Depth to top _____ Bottom _____ Total Depth of Well 4337 Feet
Show depth and thickness of all water, oil and gas formations.

OIL, GAS OR WATER RECORDS

CASING RECORD

FORMATION	CONTENT	FROM	TO	SIZE	PUT IN	PULLED OUT
Shale& Red Beds		0	610			
Anhydrite		610	623			
Shale& Red Beds		623	710			
Sand		710	890			
Shale& Red Beds		890	1275			
Anhydrite		1275	1290	8 5/8"	1290'	-0-

Describe in detail the manner in which the well was plugged, indicating where the mud fluid was placed and the method or methods used in introducing it into the hole. If cement or other plugs were used, state the character of same and depth placed, from _____ feet to _____ feet for each plug set.

0 to 45' - 15 Sacks Cement

45' --Wood Plug

45' to 495' - Heavy Mud

495' to 600' - 35 Sacks Cement

600' --Wood Plug

600' to 4337' - Heavy Mud

RECEIVED
STATE CORPORATION COMMISSION

JUN 29 1964

CONSERVATION DIVISION
Wichita, Kansas

(If additional description is necessary, use BACK of this sheet)

Name of Plugging Contractor Rains& Williamson Oil Co.
Address Wichita Plaza Bld'g Wichita, Kansas

STATE OF Kansas COUNTY OF Sedgwick, ss.
Heber Beardmore

(employee of owner) or (owner or operator) of the above-described well, being first duly sworn on oath, says: That I have knowledge of the facts, statements, and matters herein contained and the log of the above-described well as filed and that the same are true and correct. So help me God.

(Signature) Heber Beardmore
827 Beacon Bld'g, Wichita, Kansas
(Address)

SUBSCRIBED AND SWORN to before me this 25th day of June, 19 64

My commission expires July 13, 1967

Shirley Ann Jackson
Shirley Ann Jackson Notary Public.



ROTARY DRILLING LOG

Operator: Beardmore Drilling Company
 NO. 4 HULING
 C NE SW Sec. 15-21S-21W
 Hodgeman County, Kansas

Contractor: Rains & Williamson
 Oil Co.
 Commenced: 6-7-64
 Completed: 6-20-64
 Remarks: Set 1292' of 8-5/8"
 surface casing at 1289'
 with 600 sacks common
 cement.

FORMATIONS:

Surface Clay	40'
Sand	120'
Shale	485'
Red Bed & Shale	610'
Anhydrite	623'
Shale & Red Bed	710'
Sand	890'
Red Bed & Shale	1275'
Anhydrite	1305'
Shale	1480'
Shale & Shells	2080'
Lime & Shale	2925'
Shale & Lime	3675'
Lime & Shale	3750'
Lime	3880'
Lime & Shale	4287'
Lime	4317'
Lime & Chert	4337'
Rotary Total Depth (D&A)	4337'

RECEIVED
 STATE CORPORATION COMMISSION
 JUN 29 1964
 CONSERVATION DIVISION
 Wichita, Kansas

We certify the above log is true and
 correct to the best of our knowledge
 and belief.

RAINS & WILLIAMSON OIL CO.

Wilson Rains
 Wilson Rains, Partner

Subscribed and sworn to before me, a Notary Public in and for the
 State of Kansas, County of Sedgwick, this 22nd day of June, 1964.

My Commission Expires:
 January 8, 1968

Shirley Reck
 Shirley Reck, Notary Public